

KANSAS

FORM 51 5M 10-41 PETROL


Russell

Section 32 Township 14 Range 12-W

Well No. #3 Borrell

Company Texas

Greenvale Pool
NORTH

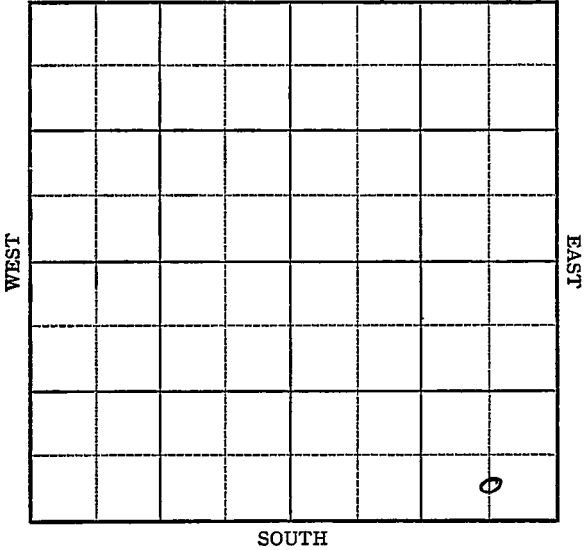

Sec. 32 Twp. 14 R. 12-W

Well No. #3 Borrell Farm

Texas

Company


(Greenvale Pool)

_____ Ft. from N. Line

330 Ft. from S. Line

660 Ft. from E. Line

_____ Ft. from W. Line

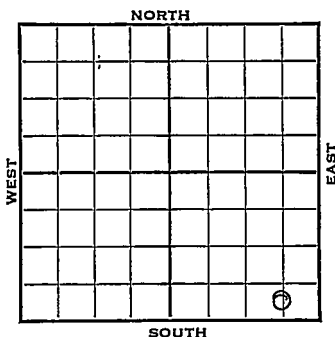

1942

REPORT

8/27 Drlg. 204'.

9/2 10" - 300

Drlg. 2686

9/9 Lans 2865 oil 3168 TD 3170
5" @ 3168 Rust.

9/16 Lans. 2865 5" - 3168

Pump 276 Pot.

T.D. 3170

Gravity 39.

COMPLETED

Russell

KANSAS

Map No. 56 Sec. 32 Twp. 14 R. 12WWell No. 3 Borrell

Texas

Company

FIRST REPORT

Contractor

C SL SE SE

SECTION PLAT Ft. from N. Line330

Ft. from S. Line

660

Ft. from E. Line

 Ft. from W. Line

GREENVALE POOL

			o

RECORDLocation Cased in., ft.Rig up Sand

Drilling and Remarks:

Gas Oil

Drlg. 204'

Total Depth **PRODUCTION**1st 24 hrs. Nat. 1st 24 hrs. after shot Gas Cu. Ft.Dry Hole Abandoned

Date

AUG 27 1942 19

S. J. LEWIS

Scout

Russell

KANSAS

Map No. 56 Sec. 32 Twp. 74 R. 12W

Well No. 3 Borrell

_____ Texas _____ Company

COMPLETED _____ Contractor

C SL SE SE
 _____ Ft. from N. Line
330 Ft. from S. Line
660 Ft. from E. Line
 _____ Ft. from W. Line

SECTION PLAT

GREENVALE POOL

Location _____

Rig up _____

Drilling and Remarks:

Lans 2865
5" @ 3168
Pump 276 P.D.

39° SW

RECORD

Cased _____ in., _____ ft.

Sand _____

Gas _____

Oil _____

Total Depth 3178

PRODUCTION

1st 24 hrs. Nat. _____

1st 24 hrs. after shot _____

Gas _____ Cu. Ft.

Dry Hole _____

Abandoned _____

Date

SEP 16 1942 19

S. J. LEWIS Scout