


Section 32 Township 14 Range 12-W

Well No. #5 E. A. Borell

Company Texas

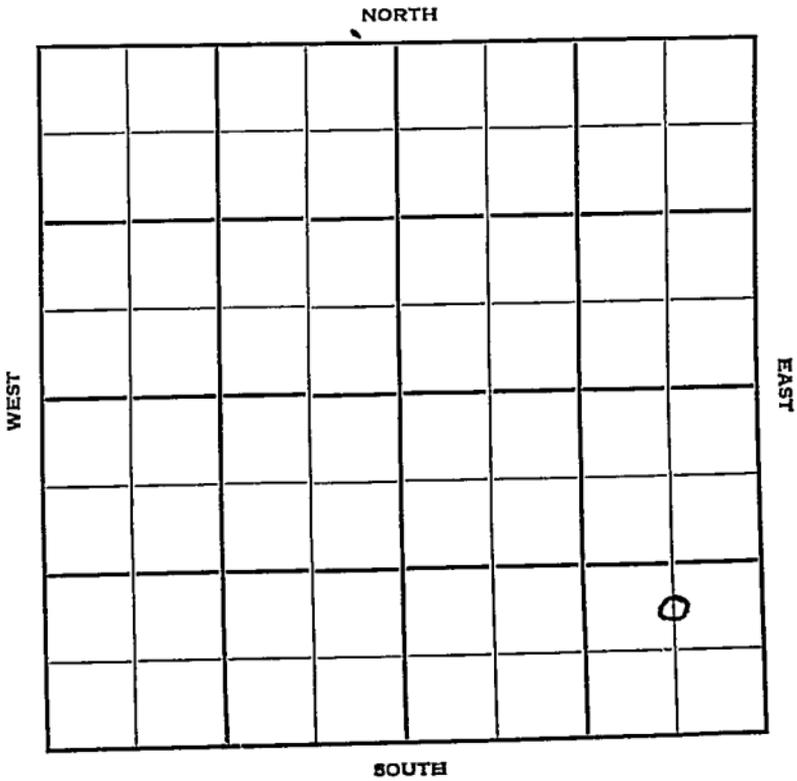

Sec. 32 Twp. 14 R. 12-W

Well No. #5 E. A. Borell Farm

Texas

Company

Powell & Peters

Contractor

Hall-Gurney


_____ Ft. from N. Line

990 Ft. from S. Line

660 Ft. from E. Line

_____ Ft. from W. Line

C N L SE SE

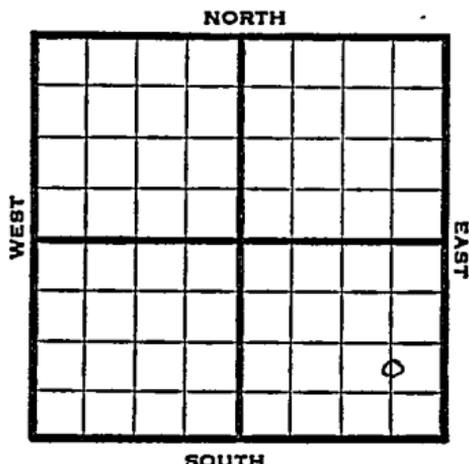

1950

Elev. 1724' REPORT

11/1

Spud 10-28-50
10" @ 650
Drlg 1507

12/13

Spud 10-28-50
Oil Well TD 3181'
10" @ 650' Heeb. 2792
Br^Line 2876! Lans. 2890'
TD 3175' 7" @ 3171
DD 3176 FU 2250 fluid 400' was oil
S/ 3/4 boph DD 3181
Regan 3174 SP 3176' S/63 bo PB 3175
B/6 to 8 bailers fluid pr hr
50% oil SP 3174 B/6 bo 15 bwph
SP 3150 CO to 3173 4/3171-72
S/13 bo 29 bw 9 hr P/15 bo 52 bwph
Comp. 15 bopd

COMPLETED

