


KANSAS

Russell County

Section 32 Township 14/13 Range 12W

Well No. #1 ~~Hilgenberg~~ Kaps

Company Jones & Shebourac

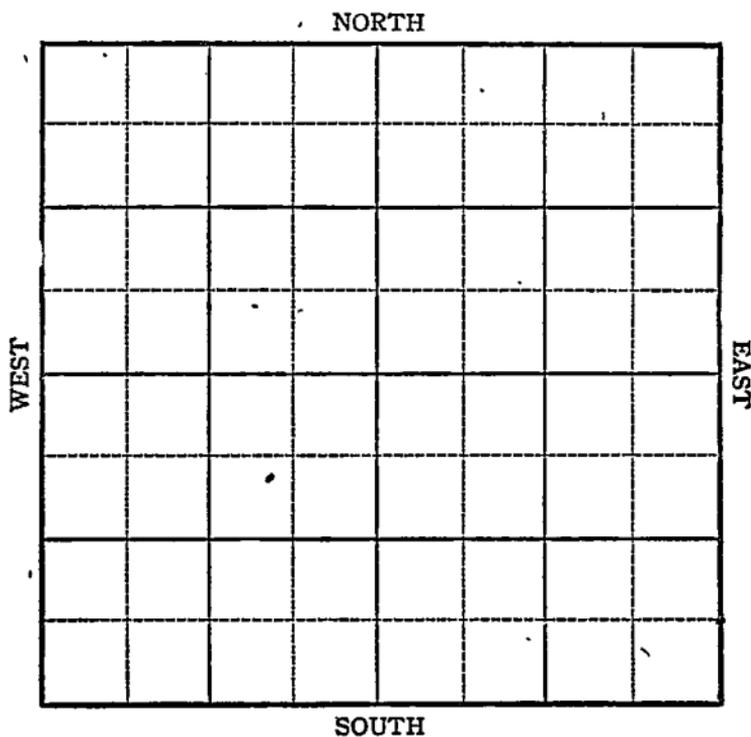

KANSAS Russell County

Sec. 32 Twp. 14 R. 12W

Well No. #1 Hilgenberg Kaps Farm

Jones & Shebourac Company


Bunker Hill

_____ Ft. from N. Line

660 Ft. from S. Line

660 Ft. from E. Line

_____ Ft. from W. Line

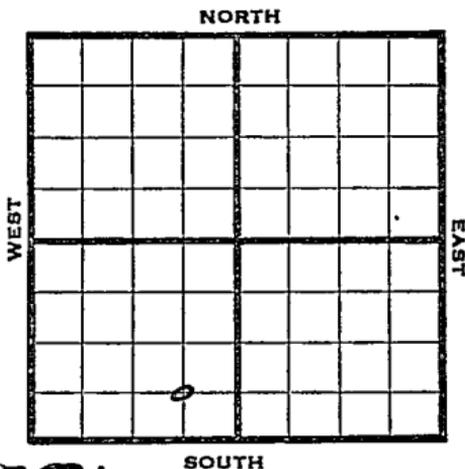

C SE SW Sec. 1751

1944

R E P O R T

10/4	Location	
10/18	"	
10/25	Cable rig	
11/2	" "	
11/8	15" @ 380	12" @ 685
	Drlg. 1585	
11/16	Anhy 678	
	10" @ 1956	
	Drlg. 2357'	
11/24	Topeka 2587	Drlg 2790
11/29	SD 3002-3010	7" @ 3030
12/6	Arb. 3203	
	5" @ 3203'	
	TD 3208'	
	SO	
	WOC	
12/14	2000' oil in 12 hrs	
12/20	Arb. 3202	
	5" @ 3202	
	TD 3208	
	Pump 172 Pot	
	38 Gravity	

COMPLETED

Pool Name Bunker Hill

Map No. 56 Sec. 32 Twp. 13 R. 12W

Well No. 1 Hilgenberg

Jones & Shebourac Company

FIRST REPORT Contractor

C SE SW

SECTION PLAT

	o		

 Ft. from N. Line

660 Ft. from S. Line

660 Ft. from E. Line

 Ft. from W. Line

Russell

Location X

Rig up

Drilling and Remarks:

RECORD

Cased in., ft.

Sand

Gas

Oil

Total Depth

PRODUCTION

1st 24 hrs. Nat.

1st 24 hrs. after shot

Gas Cu. Ft.

Dry Hole

Abandoned


Date

OCT 4 1944 19

S. J. LEWIS Scout

Pool Name Hall-GurneyMap No. 56 Sec. 32 Twp. 14 R. 12WWell No. 1 KapsJones & Shelbourne CompanyCORRECTION ContractorC SE SW

SECTION PLAT

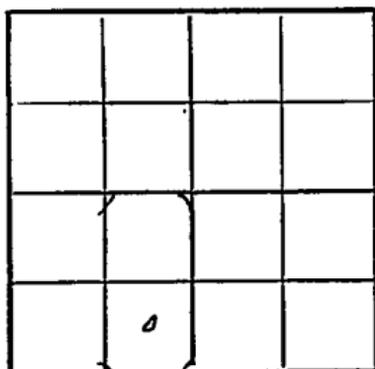 Ft. from N. Line660 Ft. from S. Line660 Ft. from E. Line Ft. from W. LineRussellLocation Rig up

Drilling and Remarks:

Reported as
#1 Hilgenberg32-13-12W

RECORD

Cased in., ft.Sand Gas Oil Total Depth

PRODUCTION

1st 24 hrs. Nat. 1st 24 hrs. after shot Gas Cu. Ft.Dry Hole Abandoned

Date

OCT 1 1 1944 19S. J. LEWIS Scout

Pool Name Hall-Burney

Map No. 36 Sec. 32 Twp. 14 R. 12W

Well No. Kaps

Jones & Shelbourne Company

COMPLETED Contractor

C SE SW

SECTION PLAT

 Ft. from N. Line

660 Ft. from S. Line

660 Ft. from E. Line

 Ft. from W. Line

Russell

Location _____

Rig up _____

Drilling and Remarks:

Cer 83202.

5' C 8202.

Pump 172 PDX

38 Gravity

RECORD

Cased _____ in., _____ ft.

Sand _____

Gas _____

Oil _____

Total Depth 8208

PRODUCTION

1st 24 hrs. Nat. _____

1st 24 hrs. after shot _____

Gas _____ Cu. Ft.

Dry Hole _____

Abandoned _____

Date

DEC 20 1944 19

S. J. LEWIS Scout