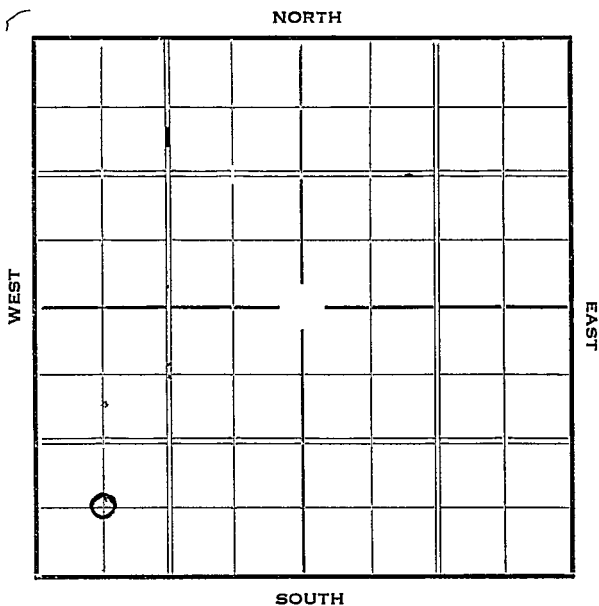
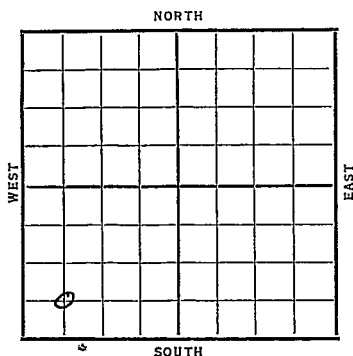


Trego

Section 34 Township 14 **KANSAS** Range 21-WWell Number 1 AllmanCompany Black Gold Oil

Sec. 34 Twp. 14 R. 21-WWell No. #1 Allman FarmBlack Gold Oil Company Ft. from N. Line660 Ft. from S. Line Ft. from E. Line660 Ft. from W. Line

Elev. 2079

Date
1936

REPORT

11/25 Location -

12/3 "

12/10 R O G

12/17 Rig.

12/24 " 12/29--

1937

1/7-----

1/14 Drlg. water well.

1/21 " " "

1/28 " " "

2/4 " " "

2/11 " " "

2/19 15" @ 80' Drlg. 870'

2/26 Drlg. 2300'

3/4 10" @ 1417. Anhydrate 1425'.

Drlg. 2620'.

3/11 Topeka 3120'. Drlg. 3344'.

3/18 Dodge 3435' KCL 3485'.

Conglomerate 3791.

Drlg. 3798'

3791
2079
1712

OVER

1937

3/25 Sil. 3890'. Drlg. 3960'.
No show.

3/31 Sil. 3890'.
T.D. 3990'.
No shows.

ABANDONED

KANSAS *Trego*Map No. *70* Sec. *34* Twp. *14* R. *21W*Well No. *1 Allman**Black Gold Oil* Company

Contractor

SECTION PLAT

0			

_____ Ft. from N. Line

660 Ft. from S. Line

_____ Ft. from E. Line

660 Ft. from W. Line

ABANDONED

Location _____

Rig up _____

Drilling and Remarks:

*Oil 3890**No shows*

RECORD

Cased _____ in., _____ ft.

Sand _____

Gas _____

Oil _____

Total Depth *3890*

PRODUCTION

1st 24 hrs. Nat. _____

1st 24 hrs. after shot _____

Gas _____ Cu. Ft.

Dry Hole ☒Abandoned ☒

Date

MA 31 1937₁₉

S. J. LEWIS Scout

KANSAS

Map No. 70 Sec. 24 Twp. 14 R. 21W

Well No. 1 Allman


Contractor

SECTION PLAT

0			

_____ Ft. from N. Line

660 Ft. from S. Line

_____ Ft. from E. Line

660 Ft. from W. Line

Location ✓

Rig up _____

Drilling and Remarks:

RECORD

Cased _____ in., _____ ft.

Sand _____

Gas _____

Oil _____

Total Depth _____

PRODUCTION

1st 24 hrs. Nat. _____

1st 24 hrs. after shot _____

Gas _____ Cu. Ft.

Dry Hole _____

Abandoned _____

Date

13 _____ 19

S. J. LEWIS

Scout