


Section 21 Township 14 Range 13 W

Well No. # 1 Sherwood

Company Lewis Mai

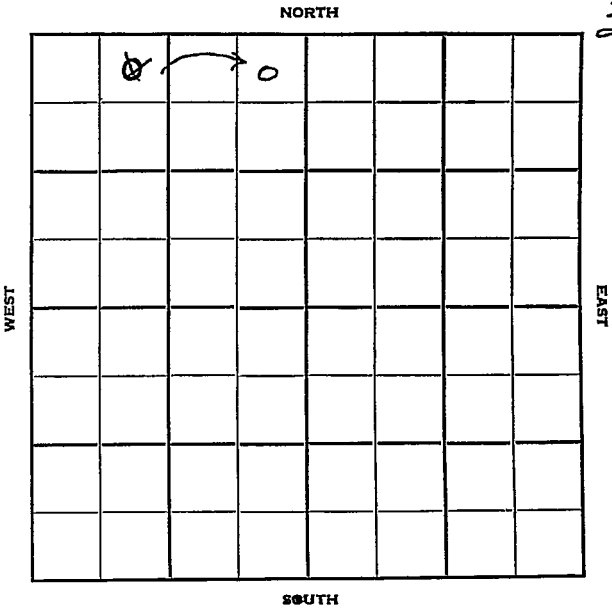

Russell

KANSAS

Sec. 21 Twp. 14 R. 13W

Well No. #1 Sherwood Farm

Lewis Mai Company

Lewis Mai Contractor

Hall Gurney


330 Ft. from N. Line

Ft. from S. Line

330' Ft. from E. Line

990 Ft. from W. Line

~~NE NW NW~~
NE NE NW

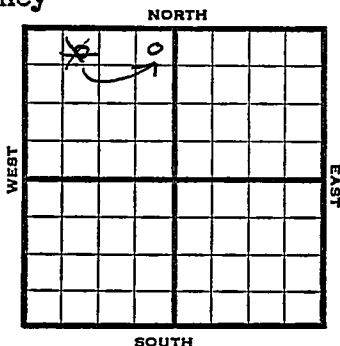

1952 Elev. 1866' REPORT

3/12 Cable tools RUR

3/19 RUR

3/25 "

4/1 Drlg. 40'

4/9 13" @ 300' 10" @ 500

Anhy 812

8" @ 812

Drlg. 1140'

4/23 Drlg. 2240'

4/30 Tarkio 2408 TD 2410 5" @ 2408
DP Hyd.

5/7 Packer stuck

5/14 Spud 3-30-52

Oil Well TD. 2410

13" @ 300 10" 500 Anhy 812

8" @ 812 Tarkio 2408 TD 2410

5" @ 2408 Hydra. FU 2000' fluid

50% wtr Comp. 25 bopd 25 bw

COMPLETED

County **Russell** State **Kansas**

Sec. **21** (Blk. Twp.) **14** (Sur. Rge.) **13W** Map No.

Operator **Lewis Mai**

Well No. **1** Farm **Sherwood**

Elev. Location **NE NW NW**

0				

530 Ft. From **N** Line **NW**

990 Ft. From **W** Line Quarter

Ist. Report **MAR 12 1952**

Completion

Remarks

Lewis Mai - Contr.

Spudding Date

Drlg. Data **Hall Gurney**

Cable tools RUR

J. G. MCGEHEE

Map No. _____ Sec. 21 Twp. 14 R. 13W

Well No. 1 Sherwood

Lewis Mai Company

~~CORRECTION~~ Contractor

NE NE NW

SECTION PLAT

330 Ft. from N. Line

_____ Ft. from S. Line

330 Ft. from E. Line

_____ Ft. from W. Line

	0		

Russell County

Location _____

Rig up _____

Drilling and Remarks:

Reported

NE NW NW

RECORD

Cased _____ in., _____ ft.

Sand _____

Gas _____

Oil _____

Total Depth _____

PRODUCTION

1st 24 hrs. Nat. _____

1st 24 hrs. after shot _____

Gas _____ Cu. Ft.

Dry Hole _____

Abandoned _____

Date

MAR 1 9 1952 19

J. G. McGEHEE

Scout

County Russell State Kansas
 Sec. 21 (Blk. 14) (Sur. 13W) (Twp.) Map No.
 Operator Lewis Mai
 Well No. 1 Farm Sherwood
 Elev. 1866 Location NE NE NW

		0		

330 Ft. From N Line NW
330 Ft. From E Line Quarter
 1st. Report _____
 Completion MAY 14 1952
 Remarks Hall-Gurney Pool
Lewis Mai - Contr.
 Spudding Date 3-30-52

Drig. Data Oil well TD 2410
13" @ 300 10" @ 500 Anhy 812
8" @ 812 Tarkio 2408 TD 2410
5" @ 2408 Hydro. FU 2000' fluid
50% water Comp. 25 bopd 25 bw

J. G. McGEHEE