


Section 22 Township 14 Range 13W

Well No. 3-- Anna Bond

Company Fred Haynes

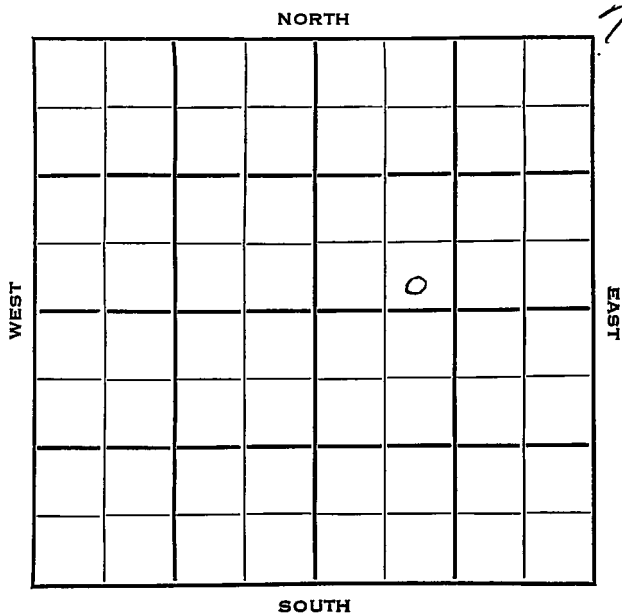

Sec. 22 Twp. 14 R. 13W

Well No. #3 Anna Bond Farm
Fred Haynes Company

Contractor


 Ft. from N. Line

330 Ft. from S. Line

 Ft. from E. Line

990 Ft. from W. Line

SE SW NE

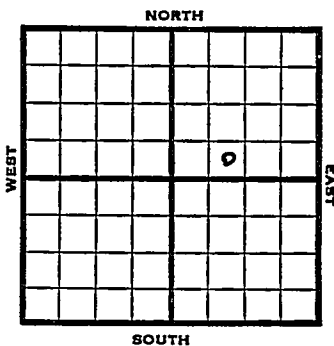

1953

Elev. 1761'

REPORT

1/21 Location
 1/29 15" @ 155
 Drlg. 200'
 2/5 Drlg. 1385'
 2/12 NR
 2/19 Tarkio 2274 5" @ 2292 TD 2299
 Sd-frac. PB /2275-85 Sd-frac.
 2/25 Spud 1-26-53 Oil well TD 2299
 15" @ 155 Tarkio 2268 5" @ 2292
 TD 2299 30/2268-75 15 GOPH
 Hydro. S/5 BOPH
 Comp. 50 BOPD

COMPLETED

County Russell State Kansas

Sec. 22 (Blk. Twp.) 14 (Sur. Rge.) 13W Map No.

Operator Fred Haynes

Well No. 3 Farm Anna Bond

Elev. _____ Location SE SW NE

FIRST REPORT
0

330 Ft. From S Line NE

990 Ft. From W Line Quarter

Ist. Report JAN 21 1953

Completion _____

Remarks _____

Spudding Date _____

Drlg. Data _____

Location _____
