


Section 34 Township 14 Range 21W

Well No. 2 Wanamaker

Company Jones, Shelburne & Farmer

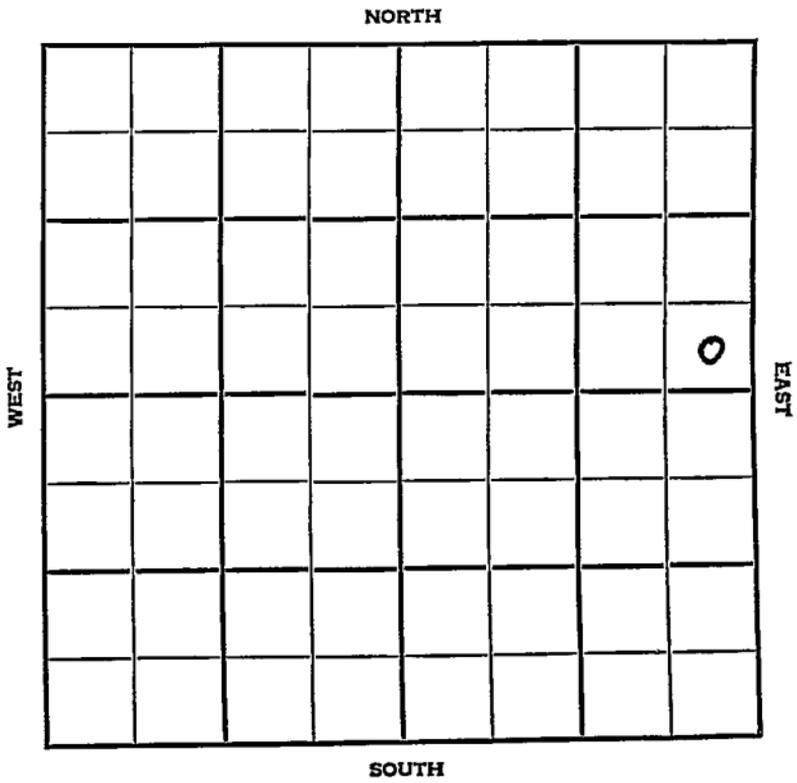

HOT FILE Trego KANSAS

SEC. 34	TWP. 14	R. 21 W
WELL NO. # 2 Wanamaker FARM		
COMPANY Jones, Shelburne & Harmer		
CONTRACTOR		


Groff Pool

_____ Ft. from N. Line

330 _____ Ft. from S. Line

330 _____ Ft. from E. Line

_____ Ft. from W. Line

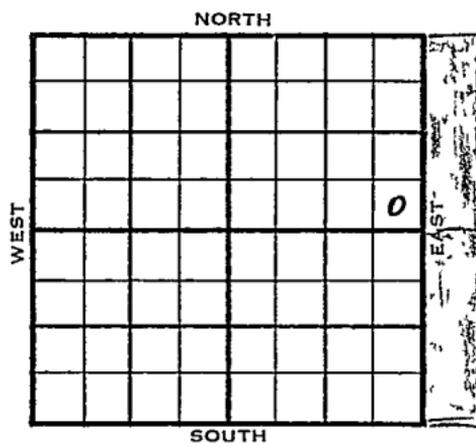

SE SE NE

MCPC has SW of 35.

1954	ELEVATION	REPORT
	2087'	
10/20	Spud 10-17-54 8" @ 160 WOC	
10/29	Lans. 3419' DST 3495-3506, open 1 hr rec 65' muddy SW. BHP 850# Drlg. 3590'	(Ltr-Gilstrap)
11/4	Rec. 515' SW on a DST in the Cong RTD 3878'	(Ltr-Gilstrap)
11/10	Spud 10-17-54 - D&A TD 3878' 8" @ 160' Heeb 3379', Tor 3398', Lans 3419' DST 3495-3506', opn 1 hr., rec. 65' muddy SW, 850# DST 3809-37', opn 45", rec. 515' SW, 550# Arb. 3868' TD 3878' D&A	

ABANDONED

3419
2087
1332

3868
2087
1781

County **Trego** State **Kansas**

Sec. **34** (Blk. Twp.) **14** (Sur. Rge.) **21W** Map No.

Operator **Jones, Shelburne & Farmer**

Well No. **2** Farm **Wanamaker**

Elev. Location **SE SE NE**

330 Ft. From **S** Line **NE**

330 Ft. From **E** Line Quarter

1st. Report **OCT 20 1954**

Completion

Remarks **MCPC has SW of 35**

Spudding Date **10-17-54**

Drlg. Data **Groff Pool**

8" @ 160 WOC

FABEN GILSTRAP