


Section 21 Township 14 Range 13W

Well No. #4 Sherwood

Company Louis Mai

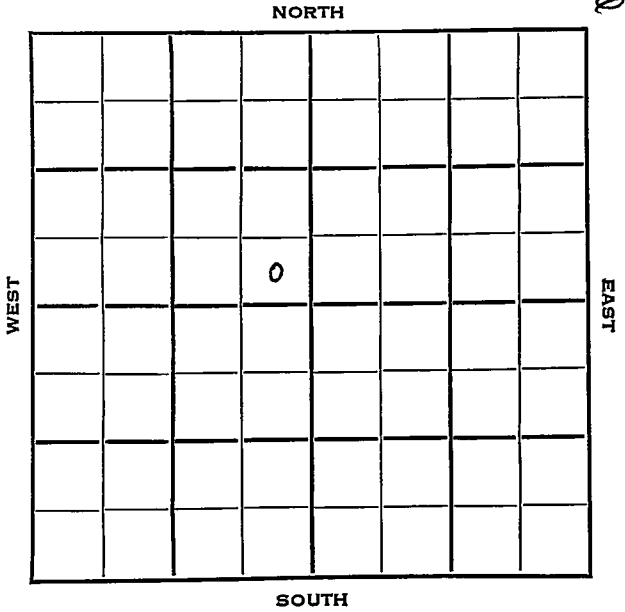

Russell KANSAS

SEC.	TWP.	R.
21	14	13 W


WELL NO. # 4 Sherwood FARM

COMPANY Louis Mai

CONTRACTOR Mast Drlg.

Hall-Gurney Pool

\_\_\_\_\_ Ft. from N. Line  
 330 \_\_\_\_\_ Ft. from S. Line  
 330 \_\_\_\_\_ Ft. from E. Line  
 \_\_\_\_\_ Ft. from W. Line

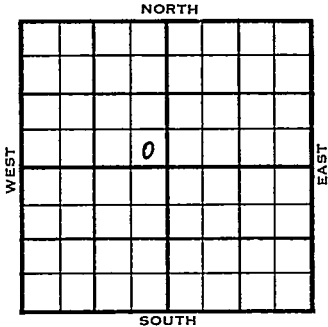

SE SE NW

1954	ELEVATION	REPORT
	1811'	

2/10 MIR  
 2/17 8" @ 219 w/125  
 1st Tarkio 2330'  
 2/24 Dover li 2341' 2nd Tarkio 2350-75  
 RTD 5" @ 2375  
 3/3 Spud 2-9-54  
 Oil Well  
 TD 2375'  
 8" @ 219'  
 Anhy 754', 1st Tarkio 2330', Dover  
 2341', 2nd Tarkio 2350'  
 TD 2375'  
 5" @ 2375'  
 36/2350-54  
 Hydro.  
 S/260 bo 24 hrs.  
 Comp. 25 bopd

COMPLETED



