


Section 22 Township 14 Range 13 W

Well No. # 2-A Jones

Company Duke & Wood

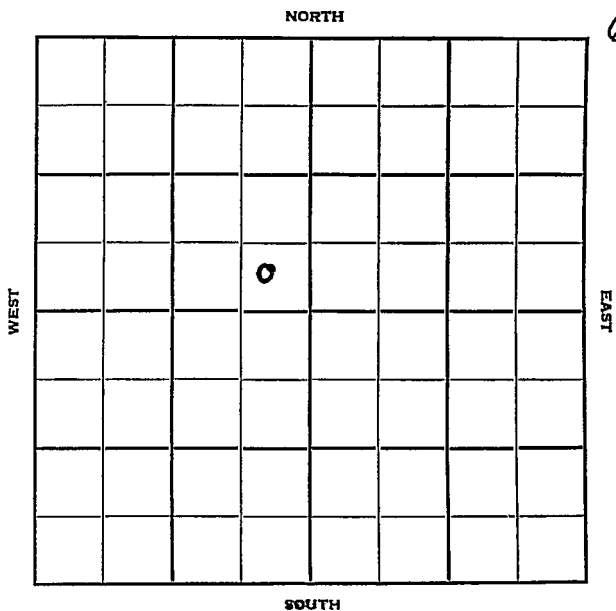



Sec. 22 Twp. 14 R. 13 W

Well No. # 2-A Jones Farm

Duke & Wood Company

Contractor


Ft. from N. Line

430 Ft. from S. Line

430 Ft. from E. Line

Ft. from W. Line

SE SE NW (Twin)

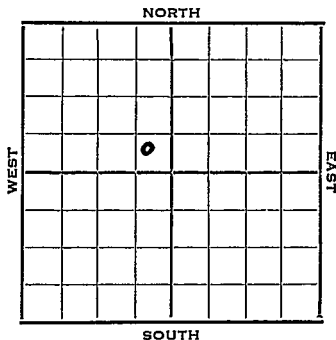

1952 Elev. 1725' REPORT

9/4 Spud 8-28-52
8" @ 212 Anhy 659'
Drlg. 2114'

9/10 Tarkio 2238-65' RTD
~~8~~ 5" @ 2265'

9/17 NR

9/24 CO 2256' 45/2240-42 B/2 gal OPH Hyd.

10/1 Spud 8-28-52
Oil well TD 2265' 8" @ 212
Anhy 659' Tarkio 2238' TD 2265'
5" @ 2265' CO to 2256' 45/2240-42
B/2 GOPH Hydro. S/4 1/2 BOPH
Comp. 50 BOPD

COMPLETED

