


Section 35 Township 14 Range 21W

Well No. #2 Holtsinger

Company Jones, Shelburne & Farmer

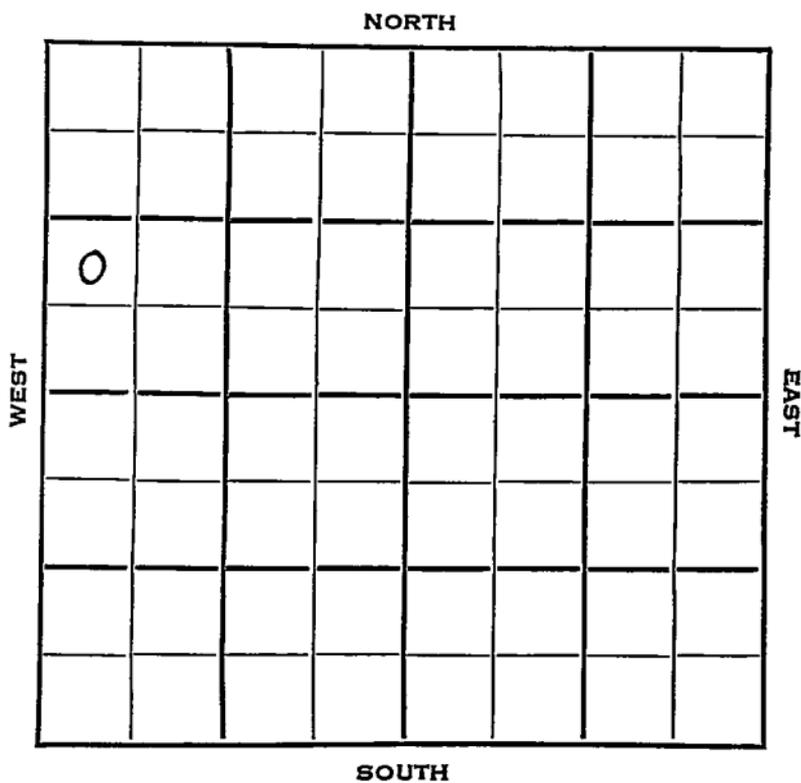

Sec. 35 Twp. 14 S R. 21 W

Well No. # 2 Holtsinger Farm
Jones, Shelburne & Farmer
~~John O. Farmer~~ Company

Jones, Shelburne & Farmer Contractor
Groff Pool

 Ft. from N. Line


990 Ft. from S. Line

 Ft. from E. Line

330 Ft. from W. Line

~~S $\frac{1}{2}$ NW $\frac{1}{4}$~~ NW SW NW

MCPC - Farmout

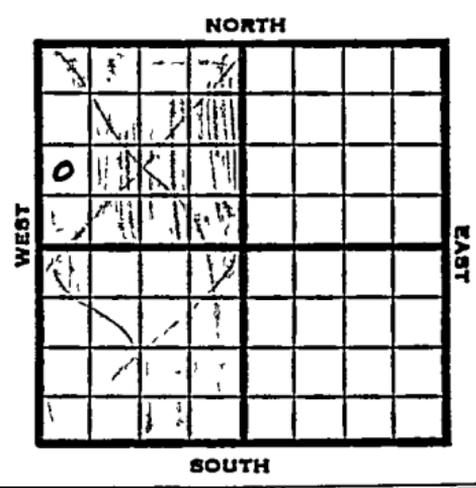

1953	Elev. 2094' RB REPORT
4/17	Arbuckle lime test approx 3850' After approval of title and not later than May 1, 1953 to commence drilling. To be completed not later than June 14, 1953.
4/21	Drlg. 2116' (Card)
4/22	Drlg. 2316' "
4/23	Drlg. 2457' " 8" @ 155 Anhy 1415' (F.R. Tkt)
4/24	No report. TD 2457' (Card)
4/23	Drlg. 2680' "
4/24	Drlg. 3047' "
4/25	Drlg. 3329' "
4/26	Drlg. 3329' "
4/27	Heeb 3381' Toronto 3403' Lans 3423' Drlg. 3592' (Card)
4/29	Heeb 3381'. Tor. 3403'. Lans 3423' Drlg. 3708' (Card)
4/30	Drlg. 3800' "
5/1	B KC 3672' Marm 3763' Cong 3819 Took DST 3825-44, open 1 hr, good strong blow thruout, rec 435' free oil, 15' OCM. BHP 600# in 15 min. FFP 150# Arbuckle 3850' TD 3864' (Card) Set pipe on bottom.

OVER

3819
2094
1725

1953
 5/A Arb. 3850' TD 3864'
 5" @ 3864' (Card)

5/4 Perf. 3833-38 w/24 shots.
 Perf. 3824-27 w/24 shots
 Starting fill-up. Prep to test. "

5/5 Well swabbed $4\frac{1}{2}$ bbls per hr on 12 hr
 swab test. Prep to sand-frac. (Card)

5/7 Tested 14 BOPH after sand-fracing
 Running rods & tubing. "

5/11 Lane Radioactivity Log given Miss
 Fannie Morrow

5/21 No report


5/28 "

6/3 Spud 4-18-53

Oil Well
 TD 3864'
 8" @ 155'
 Anhy 1415, Heeb 3381, Tor 3403, Lans
 3423, B KC 3672, Marm 3763, Cong 3819
 DST 3825-44 opn 1 hr, rec 435' free
 oil, 15' ocm 600# Arb 3850
 TD 3864
 5" @ 3864'
 24/ 3833-38 24/ 3824-27 S/ $4\frac{1}{2}$ boph
 st-frac S/ 14 boph
 Comp 289 bopd

COMPLETED

County Trego State Kansas
 Sec. 35 (Blk. 14 (Sur. 21W (Twp.) 14 (Rge.) 21W Map No.
 Operator Jones, Shelburne & Farmer
 Well No. 2 Farm Holtsinger
 Elev. 2090 Location NW SW NW

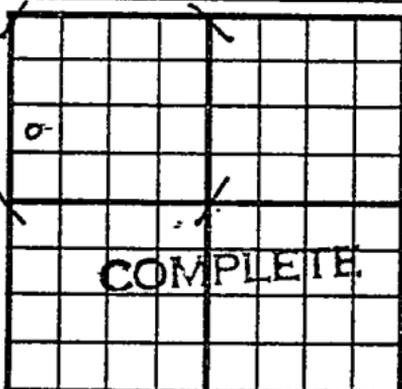

990Ft. From S Line NW
330Ft. From W Line Quarter

1st. Report

Completion JUN .3 1953

Remarks Groff Pool

D & M Drlg. - Contr.

Spudding Date 4-18-53

Drlg. Data Oil well TD 3864

8" @ 155 Anhy 1415 Heeb. 3381

Tor. 3403 Lans. 3423 B KC 3672

Marm. 3763 Cong. 3819 DST 3825-44

open 1 hr. Rec. 435' free oil 15' ocm

600# Arb. 3850 TD 3864 5" @ 3864

24/ 3833-38 24/ 3824-27 S/ 4 $\frac{1}{2}$ boph

st-frac S/ 14 boph Comp. 289 bopd


County Trego State Kansas

Sec. 35 (Blk. 14) (Sur. 21W) (Twp. 14) (Rge. 21W) Map No.

Operator Jones, Shelburne & Farmer

Well No. 2 Farm Holtsinger

Elev. _____ Location NW SW NW

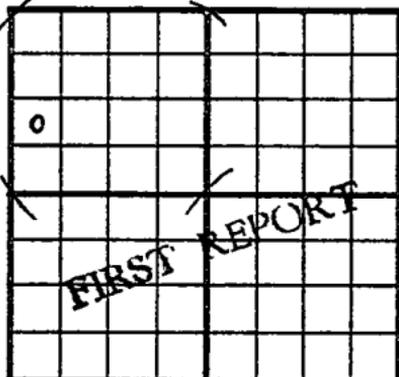

990 Ft. From S Line NW

330 Ft. From W Line Quarter

1st. Report APR 22 1953

Completion _____

Remarks Mid-Continent farmout

J-S-F - Contr.

Spudding Date 4-18-53

Drlg. Data Groff Pool

8" @ 155 Anhy 1415 drlg. 2316 2457

~~1780~~

County Wago Elev. 2086
 Sec. 35 Twp. 14 Rge. 21W
 Company Wick Pet.
 Farm Name Moore No. 1

TOPS	DEPTH	LOG	DATUM	Loc. in Sec.
Ank				SW SW NE CSL
TP				
H.	3396			
Tr.				
Dg				
Bl				
L.	✓ 3435		1349	Geol. _____
K.C.				Contr. _____
BKC				
Ce.				
C.	3829		1743	Co. tools _____
M.				Pool _____
M.				SE Graft
K.				
Nz				
Me				
V.				
S.				ABANDONED
S.	✓ 3866		1780	
A.				
R.				
PE				
G.				
TD	3870			

Date Comp. 2-14-56 FEB 29 1956

FEB 22 58 85/8 1413/575 Ø 3060

FEB 29 58 DST 3800-50 1hr see

10' 56cm BHP 620 DST

3800-70 1hr see 25' WM BHP

280 no log

10 & a