Trego


FORM 51

KANSAS

Section 35 Township 14 Range 21W

Well No. 2-A #3 Holtsinger

Company Jones, Shelburne & Farmer

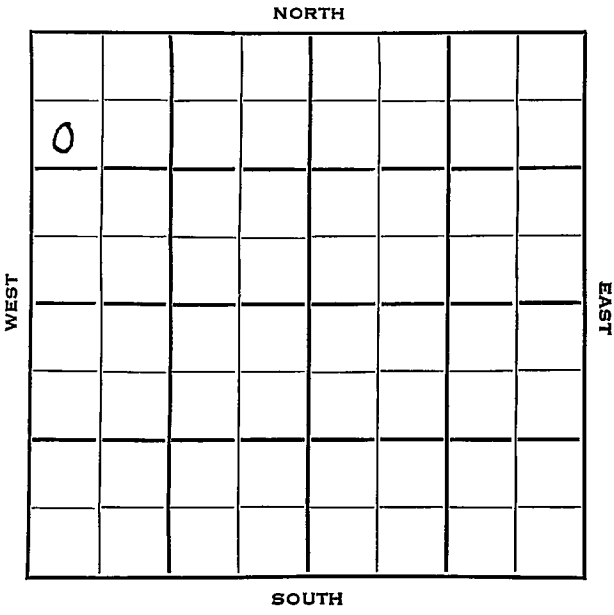

FORM 2528

HOT FILE

Trego KANSAS

Sec. 35 Twp. 14 R. 21 W

Well No. #2-A #3 Holtsinger Farm

Jones, Shelburne & Farmer Company

D & M Drlg. Contractor

Groff Pool

990 Ft. from N. Line


Ft. from S. Line

Ft. from E. Line

330 Ft. from W. Line

SW NW NW

D-X Farmout

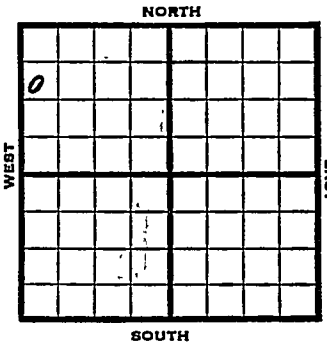

1953	Elev. 2093' REPORT Arbuckle test
4/29	Location
5/7	"
5/21	"
5/28	"
6/3	"
6/12	Moving on today (Card)
6/13	Spud 6-12-53 8-5/8" @ 175 w/135 sks. "
6/15	Drlg. 1836' "
6/16	Drlg. 2365' "
6/17	Drlg. 2690' "
6/18	Drlg. 3015' "
6/20	Drlg. 3454' "
6/22	Drlg. 3815' "
6/23	Drlg. 3840' "
6/25	Spudded 6-12-53 8" @ 175 Anhy 1410' Heeb 3380' Tor 3402' Lans 3424' Drlg. 3840' (Ltr-McGehee)
7/2	B KC 3671' Marm. 3761' Cong. 3816' TD 3860' 5" @ 3859½' CO to 3856½' 36/3745-51 2½ GOPH 3 hr. Sd-frac. S/6 BOPH for 20 hrs. (Ltr-McGehee)
7/9	Waiting on State test. " "

OVER

3816
3893
1723

1953

7/16 CO 3845' 36/3824-30
Sandfrac S/15 BOPH from the two
open zones for 4 hrs. POP (Ltr-McGhee

7/23 Waiting on State Test " "

7/29 Testing

8/5 "

8/13 Completed for 217 BOPD (Ltr-McGhee

8/12 Spud 6-12-53 Oil well TD 3860'
8" @ 175 Anhy 1410 Heeb 3380
Tor 3402 Lans 3424 B KC 3671
Marm 3761 Cong 3816
TD 3860 5" @ 3859 CO to 3756
36/3745-51 2½ GOPH 3 hr. Sd-frac.
S/6 BOPH 20 hr. CO to 3845
36/3824-30 sd-frac. S/15 BOPH
Comp. 217 BOPD

COMPLETED

FORM 275 FOR SALE BY KANSAS BLUE PRINT CO.


County Trego State Kansas

Sec. 35 (Blk.) (Twp.) 14 (Sur.) (Rge.) 21W Map No.

Operator Jones, Shelburne & Farmer

Well No. 3 Farm Holtsinger

Elev. Location SW NW NW

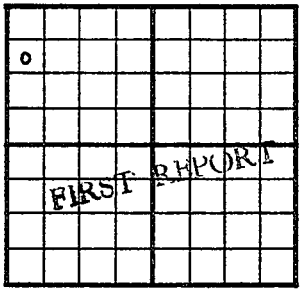

990 Ft. From N Line NW

330 Ft. From W Line Quarter

1st. Report APR 2 9 1953

Completion

Remarks Mid-Continent Farmou

D & M Drlg. - Contr.

Spudding Date

Drlg. Data Graff Pool

Location

J. G. McGEHEE

FORM 26 200 BKS. 4-52 PETROL

Kansas

Map No. _____ Sec. 35 Twp. 14 R. 21W

Well No. 2-A Holtsinger


Jones, Shelburne & Farmer Company

CORRECTION

_____ Contractor

SW NW NW

SECTION PLAT

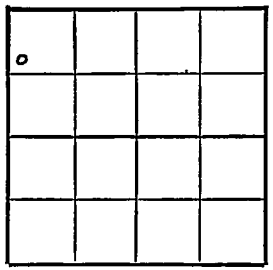

990 Ft. from N. Line

_____ Ft. from S. Line

_____ Ft. from E. Line

330 Ft. from W. Line

Trego County

Location _____

Rig up _____

Drilling and Remarks:

Reported
#3 Holtsinger

RECORD

Cased _____ in., _____ ft.

Sand _____

Gas _____

Oil _____

Total Depth _____

PRODUCTION

1st 24 hrs. Nat. _____

1st 24 hrs. after shot _____

Gas _____ Cu. Ft.

Dry Hole _____

Abandoned _____

Date

JUN 24 1953 19

J. G. McGEHEE Scout

FORM 275 FOR SALE BY KANSAS BLUE PRINT CO.


County Trego State Kansas

Sec. 35 (Blk. Twp.) 14 (Sur. Rge.) 21W Map No.

Operator Jones, Shelburne & Farmer

Well No. 2-A Farm Holtsinger

Elev. 2093 Location SW NW NW

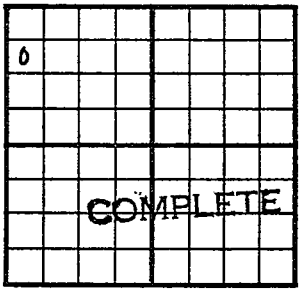

990 Ft. From N Line NW

330 Ft. From W Line Quarter

1st. Report

Completion AUG 1 2 1953

Remarks Groff Pool

D & M Drlg. - Contr.

Spudding Date 6-12-53

Drlg. Data Oil well TD 3860

8" @ 175 Anhy 1410 Heeb. 3380

Tor. 3402 Lans. 3424 B KC 3671

Marm. 3761 Cong. 3816 TD 3860

5" @ 3859 CO to 3756 36/ 3745-51

2½ goph 3 hr. sd-frac S/ 6 boph 20 hr.

CO to 3845 36/ 3824-30 sd-frac

S/ 15 boph Comp. 217 bopd

J. G. McGEHEE