


Section 22 Township 14 Range 13 W

Well No. # 5 Anna Bond

Company Fred Haynes

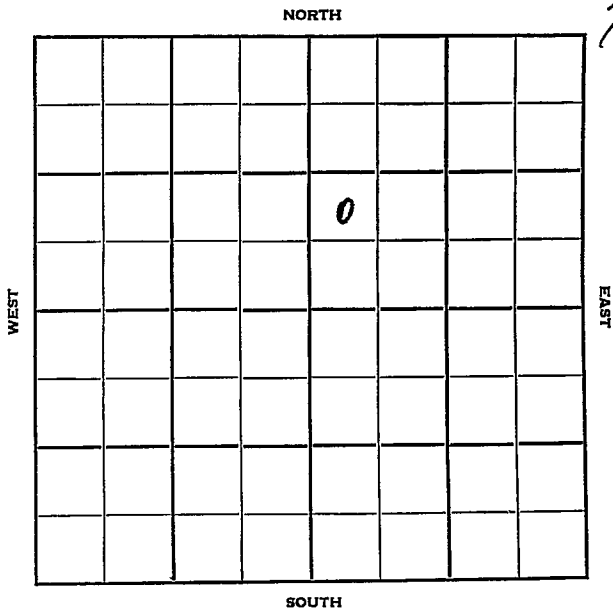

Sec. 22 Twp. 14 R. 13 W

Well No. # 5 Anna Bond Farm

Fred Haynes Company

Haynes Contractor


_____ Ft. from N. Line

990 Ft. from S. Line

_____ Ft. from E. Line

330 Ft. from W. Line

NW SW NE

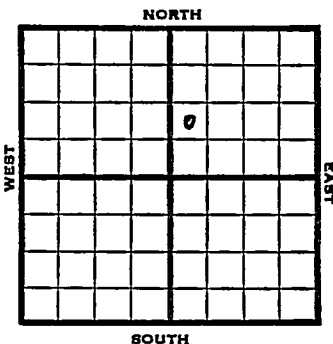

1953

Elev. 1769' REPORT

6/17
6/24

MICT
Drlg.

7/1

10" @ 649
Anhy 650
Drlg. 2050'

7/8

Tarkio 2275-2315 TD
5" @ 2304'
CO 2315
sd-frac.

7/22

Spud 6-17-53 Oil well TD 2315
10" @ 649 Anhy 650 Tarkio 2275
TD 2315 5" @ 2304 CO to 2315
Sd-frac.
Comp. 50 BOPD 10% wtr.

COMPLETED

