


Section 22 Township 14 Range 13W

Well No. #2 Campbell

Company Lewis Mai

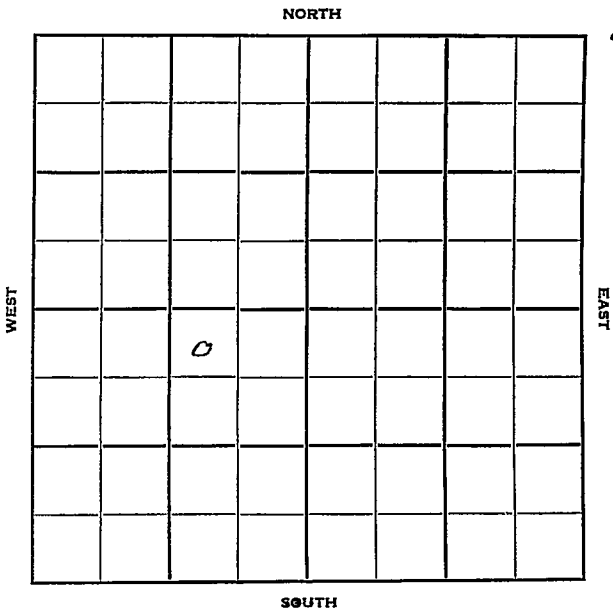

Russell

KANSAS

Sec. 22 Twp. 14 R. 13W

Well No. #2 Campbell Farm

Lewis Mai Company

Hall Gurney Contractor


330' Ft. from N. Line

 Ft. from S. Line

990' Ft. from E. Line

 Ft. from W. Line

NW NE SW

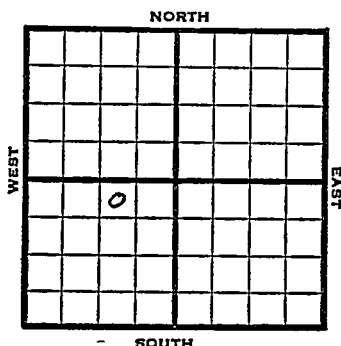

1952 Elev. 1747 REPORT

5/21	Location
5/28	"
6/11	"
6/18	"
6/25	12" @ 260' 10" @ 400 Anhy 700' 8" @ 700 Drlg. 980'
7/2	Drlg. 1900'
7/9	Tarkio 2267 5" @ 2266
7/17	DD 2270 TD B/2 galoph D-Hyd S/1 BOPH
7/23	Spud 6-17-52 Oil Well TD 2270 15" @ 30 12" @ 260 10" @ 400 Anhy 700 8" @ 700 Tarkio 2267 5" @ 2266 TD 2270 B/2 goph D-Hydro S/1 boph Comp. 40 bopd

County Russell State Kansas

Sec. 22 (Blk. Twp.) 14 (Sur. Rge.) 13W Map No.

Operator Lewis Mai

Well No. 2 Farm Campbell

Elev.	1747	Location	NW NE SW
-------	------	----------	----------

[illegible]

330 Ft. From N Line SW

990 Ft. From E Line Quarter

- 1st. Report

Completion .1111 2 3 1952

Remarks	Hall-Gurney Pool
---------	------------------

Spudding Date 6-17-52

Drlg. Data Oil well TD 2270

15" @ 30 12" @ 260 10" @ 400

Anhv 700 8" @ 700 Tarkio 2267

5" @ 2266 TD 2270 B/ 2 goph

D-Hydro: S/ 1 bopb Corno. 40 bopd

J. G. McGEHEE