

Trego


KANSAS

SECTION 35 TOWNSHIP 14 RANGE 21 W

WELL NO. #5 Wagoner

COMPANY Wicks Pet.

NORTH

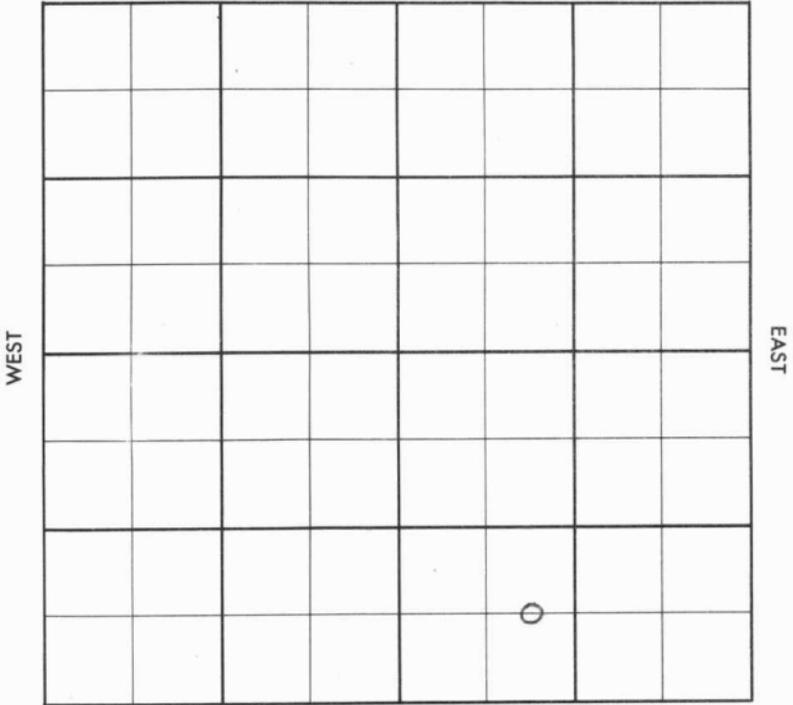

SOUTH

Trego

KANSAS

SEC. 35	TWP. 14	R. 21W
------------	------------	-----------

WELL NO.

#5 Wagoner

FARM

COMPANY

Wicks Petr.


CONTRACTOR

_____ Ft. from N. Line

_____ Ft. from S. Line

_____ Ft. from E. Line

_____ Ft. from W. Line

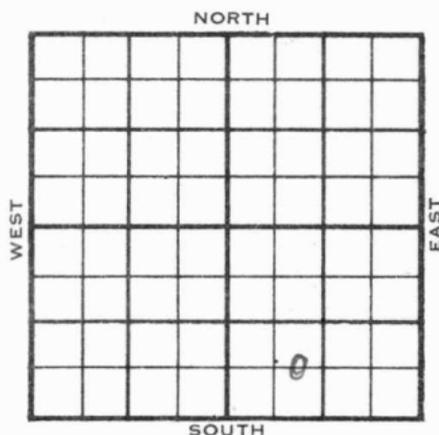C E $\frac{1}{2}$ SW SESDX - $\frac{1}{4}$ mile

	ELEVATION	REPORT
1956	2059'	
1-18	Location	
1-27	Moving in Rotary	
2-2	Drlg. 2500'	
2-8	Spud 1-26-56, 8 5/8" @ 1380, Anhy 1376, Heeb. 3362 Tor. 3381, Land. 3401 BKD 3649 Mamm. lime 3734 Cong. 3786 DST 3460-95, op 1 hr. rec. 50' mw, 1130/20" DST 3740-52, op 1 hr. rec. 10' hocm 120' socsw, 1060/20" DST 3777-3805	
2-16	DST 3777-3805, op 1 hr. rec. 30' ocm, 8' free oil, 420/20" DST 3800-15, op 1 hr. gas to surface in 45 min, rec. 1508' free oil, 1050/20" 5 1/2" @ 3859/100	
2-23	CO, 40/ 3810-27, S/ 12 3/4 boph, 6 hrs. T & R	
ox 3-1	No report	

1956

3-8 No report

3-15 No report

3-21 DST 3800-15 op 1 hr. gas to surface
in 45 min, rec. 1508' free oil,
1050/20"
5 $\frac{1}{2}$ " @ 3859/100
CO 40/ 3810-27
S/ 12 $\frac{1}{2}$ boph, 6 hrs.
Comp. 232 bopd
Anh. 1376
H. 3362
Tr. 3381
L. 3401
BKC 3649
Ma Li. 3734
C. 3786
A. 3839
TD 3860'

COMPLETED

County Trego Elev. 2059
 Sec. 35 Twp. 14 Rge. 21W
 Company Wicks Pet.
 Farm Name Wagoner No. 5

TOPS	DEPTH	LOG	DATUM	Loc. in Sec.
Anh.				C E $\frac{1}{2}$ SW SE
Tr.				
Dg.				
B.L.				
L.				Geol.
K.C.				Contr.
B.K.C.				
Ce.				
C.				
M.				Pool
M.				
K.				
Mz.				
Mq.				
V.				
S.				
S.				
A.				
R.				
Pe.				
G.				
T.D.				

JAN 18 '56
 FIRST REPORT
 4 mi.

Date Comm. _____
 Location _____

[Large handwritten signature]

Co.
 Lse.
 No.
 Sec.
 T.
 R.

County Trego Elev. 2059
 Sec. 35 Twp. 14 Rge. 21W
 Company Wicks Pet.
 Farm Name Wagoner No. 5

TOPS	DEPTH	LOG	DATUM
Anh.	<u>1376</u>		
Tp.			
H.	<u>3362</u>		
Tr.	<u>3381</u>		
Dg.			
B.L.			
L.	<u>3401</u>		<u>1342</u>
K.C.			
B.K.C.	<u>3649</u>		<u>1590</u>
Ce. <u>Ma Li</u>	<u>3734</u>		<u>1675</u>
C.	<u>3786</u>		<u>1727</u>
M.			
M.			
K.			
Mz.			
Mq.			
V.			
S.			
S.			
A.	<u>3839</u>		<u>1780</u>
R.			
Pe.			
G.			
T.D.	<u>3860</u>		

Loc. in Sec. C E¹/₂ SW SE

Geol. _____

Contr. _____

Pool _____



Date Comm. 1-26-56 MAR 21 1956
8 5/8" @ 1380 DST 3460-95 open 1 hr.
rec. 50' mw 1130/20" DST 3740-52
open 1 hr. rec. 10' hocm 120' socsw
1060/20" DST 3777-3805 open 1 hr.
rec. 30' ocm 8' free oil 120/20"
DST 3800-15 open 1 hr. gas to surface
in 45 min. rec. 1508' free oil
1050/20" 5 1/2" @ 3859/100 CO 40/ 3810-
27 S/ 12 1/2 boph 6 hr. Comp. 232 bopd

Co.
Lse.
No.
Sec.
T.
R.