


Section 35 Township 14 Range 21W

Well No. #1 Moore

Company G M R

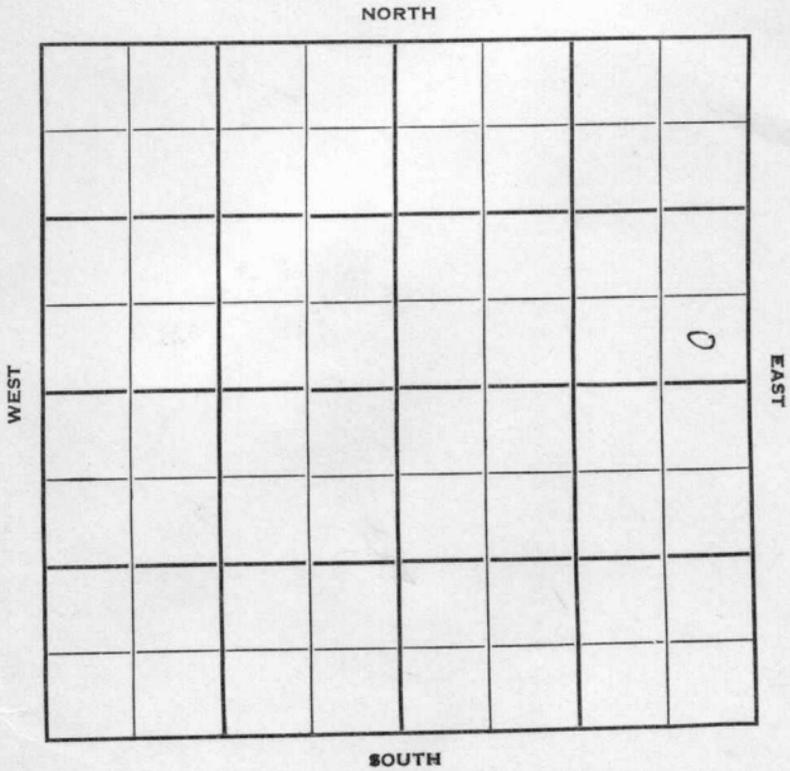


Sec. 35 Twp. 14 R. 21W

Well No. #1 Moore Farm

G-M-R Company

Wildcat Contractor

Ft. from N. Line
330' Ft. from S. Line
330' Ft. from E. Line
Ft. from W. Line

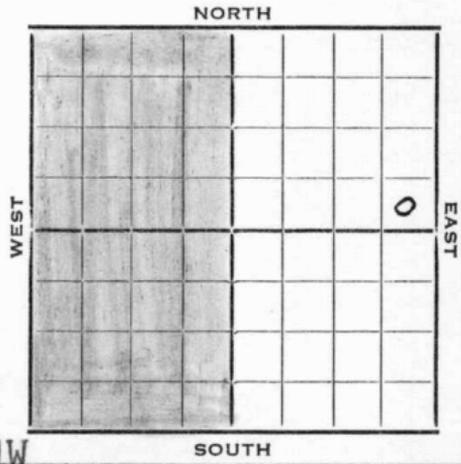

Stanolind \$2500

SE SE NE

MCPC has $W\frac{1}{2}$ of 35-14-21W

1952

Elev. 2081' REPORT

4/16

Spud 4-14-52

4/23

8" @ 216' Heeb 3374', Tor 3396'
Lans. 3416'
Drlg. ahead.

4/30

Spud 4-14-52
D & A TD 3904' 8" @ 216
Heeb 3374' Tor. 3396' Lans. 3416'
DST 3493-3505 open 3/4 hr. rec 60' SW
Miss 3750'
DST 3756-92 open 38 min, rec 30' mud
Arb. 3870'
TD 3904' D & A

ABANDONED


County **Trego** State **Kansas**

Sec. **35** (Blk. Twp.) **14** (Sur. Rge.) **21W** Map No.

Operator **G-M-R Oil**

Well No. **1** Farm **Moore**

Elev. **2081** Location **SE SE NE**

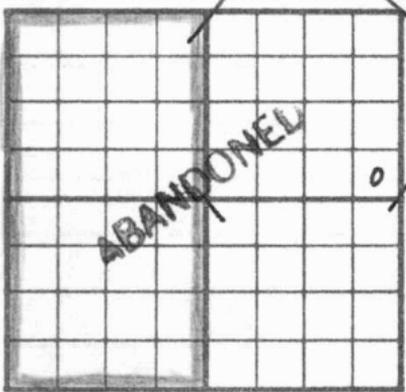

330 Ft. From **S** Line **NE**

330 Ft. From **E** Line **Quarter**

Ist. Report

Completion **APR 30 1952**

Remarks **Wildcat**

Spudding Date **4-14-52**

Drlg. Data **D & A** **TD 3904**

8" @ 216 Heeb. 3374 Tor. 3396

Lans. 3416 DST 3493-3505 open 3/4 hr.

Rec. 60' sw Miss. 3750 DST 3756-92
open 38 min. Rec. 30' mud Arb. 3870

TD 3904 D & A

J. G. McGEHEE


County **Trego** State **Kansas**

Sec. **35** (Blk. Twp.) **14** (Sur. Rge.) **21W** Map No.

Operator **G-M-R**

Well No. **1** Farm **Moore**

Elev. Location **SE SE NE**

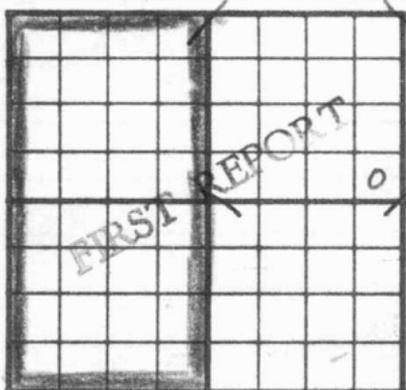

330 Ft. From **S** Line **NE**

330 Ft. From **E** Line Quarter

1st. Report **APR 16 1952**

Completion

Remarks **Stanolind \$2500.**

MCPC has W $\frac{1}{2}$ of 35-14-21W

Spudding Date **4-14-52**

Drlg. Data **Wildcat**

J. G. McGEHEE