


Section 22 Township 14 Range 13W

Well No. #6 Anna Bond

Company Fred Haynes

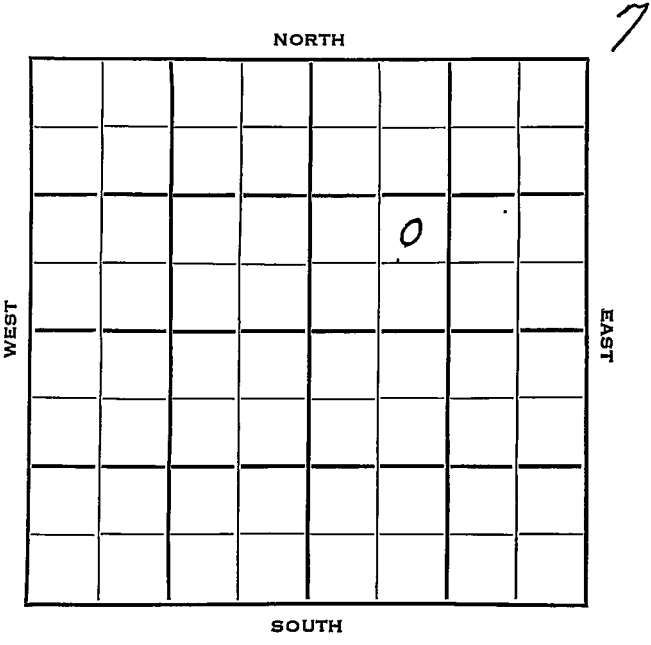

Sec. 22 Twp. 14 R. 13W

Well No. #6 Anna Bond Farm

Fred Haynes Company

Haynes Contractor

Hall-Gurney Pool


Ft. from N. Line

990 Ft. from S. Line

Ft. from E. Line

990 Ft. from W. Line

NE SW NE

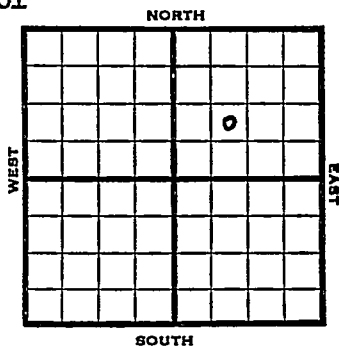

1953 Elev. 1775' REPORT

7/8 C&P

7/22 REST

7/29 NR

8/5 15" @ 60'  
 Anhy 712  
 8" @ 712  
 7" @ 2155  
 Drlg.

8/12 Spud 7-20-53 Oil well TD 2318  
 15" @ 60 Anhy 712 8" @ 712  
 7" @ 2155 Zarkio 2309 5" @ 2309  
 TD 2318' 18 GOPH 8 hr. sd-oil-frac.  
 S/14 BOPH  
 Comp. 50 BOPD

**COMPLETED**

County **Russell** State **Kansas**

Sec. **22** (Blk. Twp.) **14** (Sur. Rge.) **13W** Map No.

Operator **Fred Haynes**

Well No. **6** Farm **Anna Bond**

Elev. \_\_\_\_\_ Location **NE SW NE**


**FIRST REPORT**

**990** Ft. From **S** Line **NE**

**990** Ft. From **W** Line Quarter

Ist. Report **JUL 8 1953**

Completion \_\_\_\_\_

Remarks \_\_\_\_\_

**Haynes - Contr.**

Spudding Date \_\_\_\_\_

Drlg. Data **Hall-Gurney pool**

**G & F**

**J. G. McGEHEE**

County Russell State Kansas

Sec. 22 (Blk. Twp.) 14 (Sur. Rge.) 13W Map No.

Operator Fred Haynes

Well No. 6 Farm Anna Bond

Elev. 1775 Location NE SW NE

			0		
COMPLETE					

990 Ft. From S Line NE

990 Ft. From W Line Quarter

Ist. Report

Completion AUG 12 1953

Remarks Hall-Gurney Pool

Haynes - Contr.

Spudding Date 7-20-53

Drlg. Data Oil well TD 2318

15" @ 60 Anhy 712 8" @ 712 7" @ 2155

Tarkio 2309 5" @ 2309 TD 23183

18 goph 8 hr. sd-oil-frac S/ 14 boph

Comp. 50 bopd