


Section 22 Township 14 Range 13W

Well No. 7 Anna Bond

Company Fred Haynes

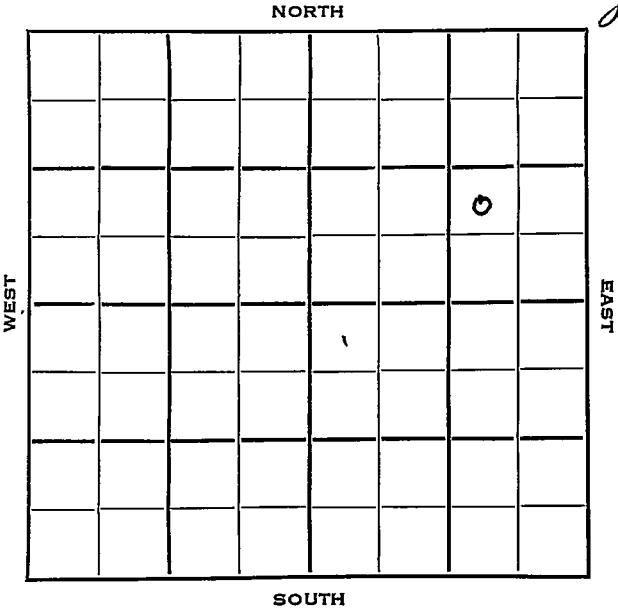

Russell

KANSAS

SEC.	TWP	R.
22	14-	13W ✓

WELL NO

#7 Anna Bond

FARM

COMPANY

Fred Haynes

CONTRACTOR

Fred Haynes

Hall-Gurney Pool

NORTH

Ft. from N. Line

990

Ft. from S. Line

990

Ft. from E. Line

Ft. from W. Line

						0	

WEST

EAST

SOUTH

NW SE NE

	ELEVATION	REPORT
1953	1777'	

9/16

Spud 9-13-53
Drlg 250'

9/23

12" @ 42'
10" @ 410'
Anhy 715'
8" @ 715'
Drlg. 1300'

9/30

Drlg 2268'

10/14

Spud 9-13-53
Oil Well
TD 2318'
12" @ 42
10" @ 410
Anhy 715'
8" @ 715
1st Tarkio 2292', 2nd Tarkio 2312'
5" @ 2310
B/12 goph 3 hrs.
TD 2316
DD 2318, 20/2292-97,
Sd-frac, S/5 boph
Comp. 25 bopd 10% wtr.

COMPLETED

J. G. McGEHEE

County Russell State Kansas

Sec. 22 (Blk. Twp.) 14 (Sur. Rge.) 13W Map No.

Operator Fred Haynes

Well No. 7 Farm Anna Bond

Elev. 1777 Location NW SE NE

COMPLETE

990 Ft. From S Line NE

990 Ft. From E Line Quarter

1st. Report **OCT 14 1953**

Completion

Remarks Hall-Gurney Pool

Fred Haynes - Contr.

Spudding Date 9-13-53

Drilg. Data Oil well TD 2318

12" @ 42 10" @ 410 Anhy 715 8" @ 715

1st Tarkio 2292 2nd Tarkio 2312

5" @ 2310 B/ 12 goph 3 hr. TD 2316

DD 2318 20/ 2292-97 sd-frac S/ 5 boph

Comp. 25 bopd 10% wtr.