


SECTION 35 TOWNSHIP Trego 14 RANGE 21 W **KANSAS**

WELL NO. #1 Wagoner

COMPANY Wiekizer Pet.

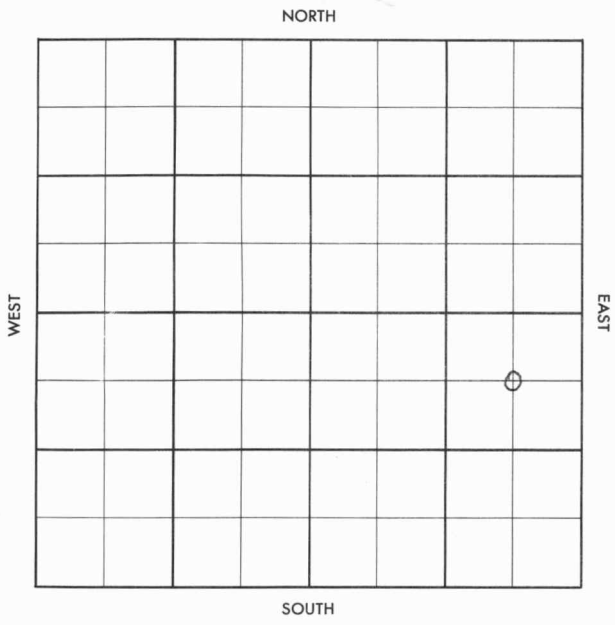

Trego

KANSAS

SEC. 35	TWP. 14	R. 21W
------------	------------	-----------

WELL NO.

#4 Wagoner

FARM

COMPANY

Wickizer Pet.

CONTRACTOR

Co. Tools

SE Groff


_____ Ft. from N. Line

_____ Ft. from S. Line

_____ Ft. from E. Line

_____ Ft. from W. Line

~~Q E 1/2 E 1/2 SE~~
~~G NE SE (TWIN WELL)~~

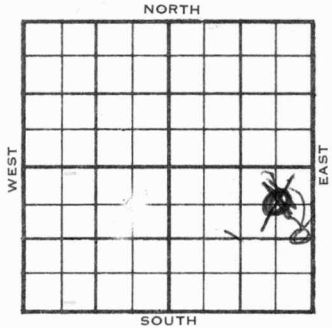

SDX 1/2 mile

	ELEVATION	REPORT
1956	2064'	
1-11	Comm. 1-8-55 8" @ 1400 WOC	
1-19	Drlg. 3450	
1-27	Pipe set, TD 3873	
2-2	Tubing & rods	
2-8	Marm. lime 3738 Cong. 3791 DST 3742-60 op 1 hr. rec. 150' msw, 1080/20" DST 3778-3815, op 1 hr. rec. 30' GIP, 28' ocm, 280/20" DST 377603823, op 1 hr. 660' GIP, rec. 120' so&gcm, 60' o&gcm, 230/20" DST 3819-33, op 1 hr. rec. 172' ho&gcm, 200' muddy gassy oil, 230/20", 5 1/2" @ 3872	
2-16	CO to 3841, 16/3813-17, 16/ 3823-27, 20/3830-35, S/ 12 1/2 boph, 8 hrs., T&R	
2-23	Putting on pump	
3-1	No report	
3-8	No report	
3-15	No report	

DX-78

OVER

1956

3/21 Comm 1-8-56

Anh	1375
H	3373
Tr	3394
L	3412
BKC	3656
Marm Li	3738
C Sd	3791
A	3856

TD 3873

8" @ 1400

DST 3742-60 open 1 hr. rec 150' msw
1080/20"

DST 3778-3815 open 1 hr rec 30' GIP
28' OCM 280/20"

DST 3776-3823 open 1 hr
rec 660' GIP 120' SO & GCM 60' O &
GCM 230/20"

DST 3819-33 open 1 hr rec 172' HO &
GCM 200' muddy gassy oil 230/20"

5 1/2" @ 3872

CO to 3841

16/3813-17 16/3823-27 20/3830-35

S/12 $\frac{1}{2}$ boph 8 hr

Comp 124 BOPD

COMPLETED

County Trego Elev. _____
 Sec. 35 Twp. 14 Rge. 21W
 Company Wickizer Pet.
 Farm Name Wagoner No. 4

TOPS	DEPTH	LOG	DATUM
Anh.			
Tp.			
H.			
Tr.			
Dg.			
B.L.			
L.			
K.C.			
B.K.C.			
Ce.			
C.			
M.			
M.			
K.			
Mz.			
Mq.			
V.			
S.			
S.			
A.			
R.			
Pe.			
G.			
T.D.			

Loc. in Sec. _____
C NE SE
(turning well)
 Geol. _____
 Contr. _____
Co. tools
 Pool _____
SE Groff

1/2 mile
FIRST REPORT
0
 JAN 11 '56

Date Comm. 1-8-56
8" @ 1400 WOC

Co.

Lse.

No.

Sec.

T.

R.

CORRECTION

FORM 513 REV. SUNRAY

County Trego Elev. _____
 Sec. 35 Twp. 14 Rge. 21W
 Company Wickizer Pet.
 Farm Name Wagoner No. 4

TOPS	DEPTH	LOG	DATUM
Anh.			
TP.			
H.			
Tr.			
Dg.			
Bl.			
L.			
K.C.			
B.K.C.			
Ce.			
C.			
M.			
M.			
K.			
Mz.			
Mq.			
V.			
S.			
S.			
A.			
R.			
PE.			
G.			
T.D.			

Loc. in Sec. _____
C E $\frac{1}{2}$ E $\frac{1}{2}$ SE

Geol. _____
 Contr. _____

Pool GROFF



Date Comm. MAR 28 1956
Reported C NE SE

Co.

Lse.

No.

Sec.

T.

R.

County Trego Elev. 2064
 Sec. 35 Twp. 14 Rge. 21W
 Company Wickizer Pet.
 Farm Name Wagoner No. 4

TOPS	DEPTH	LOG	DATUM
Anh.	<u>1375</u>		
Tp.			
H.	<u>3373</u>		
Tr.	<u>3394</u>		
Dg.			
Bl.			
L.	<u>3412</u>		<u>1348</u>
K.C.			
B.K.C. <u>114</u>	<u>3656</u>		<u>1592</u>
Ce. <u>Marm Li</u>	<u>3738</u>		<u>1674</u>
C. <u>sd</u>	<u>3791</u>		<u>1727</u>
M.			
M.			
K.			
Mz.			
Mq.			
V.			
S.			
S.			
A.	<u>3856</u>		<u>1792</u>
R.			
Pf.			
G.			
T.D.	<u>3873</u>		

Loc. in Sec. C E¹/₂ E¹/₂ SE

Geol. _____

Contr. _____

Co. tools _____

Pool _____

SE Groff



Date Comm. 1-8-56 MAR 2 1 1956
 8" @ 1400 DST 3742-60 open 1 hr.
 rec. 150' msw 1080/20" DST 3778-3815
 open 1 hr. rec. 30' GIP 28' ocm
 280/20" DST 3776-3823 open 1 hr.
 rec. 660' GIP 120' so & gcm 60' o & gcm
 230/20" DST 3819-33 open 1 hr.
 rec. 172' ho & gcm 200' muddy gassy oil
 230/20" 5¹/₂" @ 3872 CO to 3841

OVER

First reported as C NE SE

Completed as E/2 E/2 SE.

These do not agree. Please advise.

Thanks.

Mickey - Scouting Dept

APR 6 1956

M. MC.

16/3813-17 16/3823-27 20/3830-35
S/12 $\frac{1}{2}$ bopn 8 hr. comp. 12 $\frac{1}{2}$ bopn