


Section 22 Township 14 Range 13W

Well No. #1 Campbell

Company Lewis-Mai

NORTH

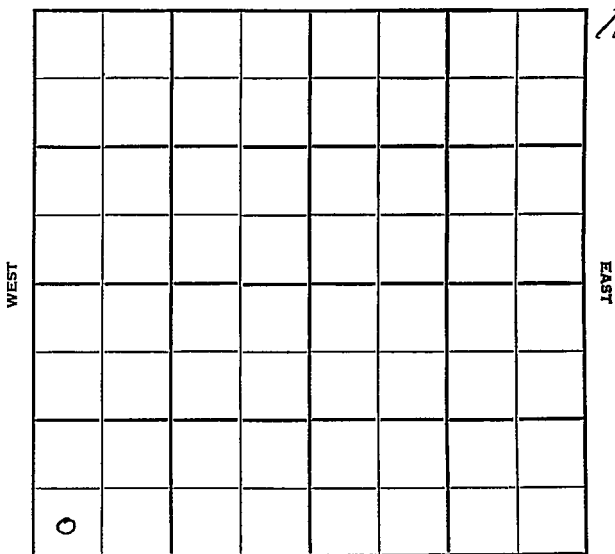

SOUTH

WEST

EAST

13

Russell **KANSAS**
14 R. 13 W

Sec. 22 Twp.

Well No. # 1 Campbell Farm

Lewis-Nai Company

Lewis Contractor
Hall Gurney

Ft. from N. Line

330
~~660~~


Ft. from S. Line

Ft. from E. Line

330
~~660~~

Ft. from W. Line

SW SW SW
~~SW SW~~

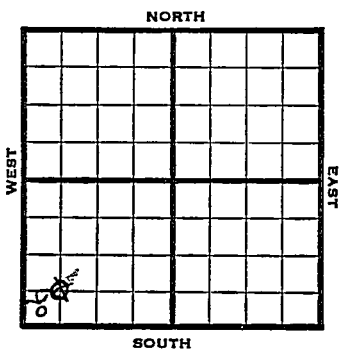

1952

Plat. 1754' REPORT

1/30

Cable Tools

2/6

" "

2/13

15" @ 146 Drlg. 350'

2/20

Anhy 695' 10" @ 700'

-Drlg. 1175'

3/5

No report

3/12

Spud 2-7-52

Oil Well TD 2274

15" @ 146

Anhy 695' 10" @ 700

Tar 2269-74 5" @ 2269

S/ 8 goph Hydro S/ 4 boph

Comp. 50 bopd

COMPLETED

County Russell State Kansas

Sec. 22 (Blk. Twp.) 14 (Sur. Rge.) 13W Map No.

Operator Lewis-Nai

Well No. 1 Farm Campbell

Elev. Location C SW SW

FIRST REPORT

See correction

OK

660 Ft. From S Line SW

660 Ft. From N Line Quarter

Ist. Report JAN 30 1952

Completion *(handwritten)*

Remarks Lewis - Contr.

Spudding Date

Drlg. Data Hall Gurney

Cable Tolls

J. G. McGEHEE

Map No. _____ Sec. 22 Twp. 14 R. 13W

Well No. 1 Campbell

Lewis-Mai Company

CORRECTION Contractor

SW SW SW

SECTION PLAT

_____ Ft. from N. Line

330 Ft. from S. Line

_____ Ft. from E. Line

330 Ft. from W. Line

Russell County

Location _____

Rig up _____

Drilling and Remarks:

Reported

G SW SW

RECORD

Cased _____ in., _____ ft.

Sand _____

Gas _____

Oil _____

Total Depth _____

PRODUCTION

1st 24 hrs. Nat. _____

1st 24 hrs. after shot _____

Gas _____ Cu. Ft.

Dry Hole _____

Abandoned _____

Date

JAN 30 1914

19

J. G. McGEHEE

Scout