Russell

KANSAS


SECTION 20 TOWNSHIP 14 RANGE 13W

WELL NO. #7 Opdyke

COMPANY C.W. Shaffer & Stearns Drlg.

5/2 5/2
~~SW SE~~ SW

NORTH

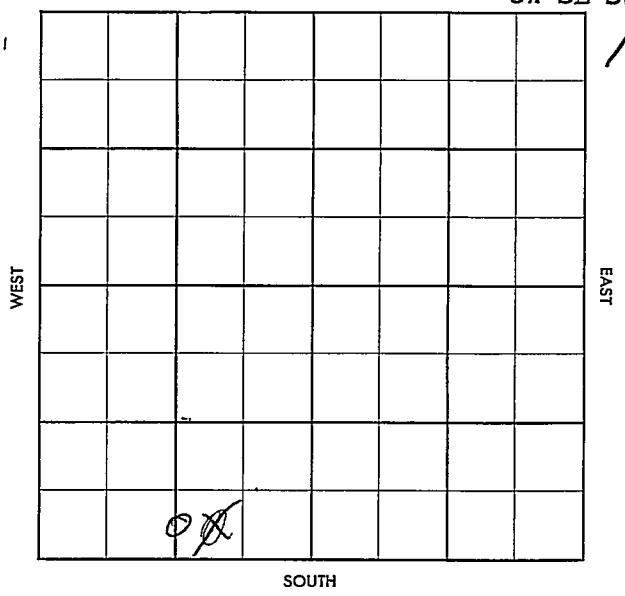

FORM 504-3 SUNRAY

FORM 513 SUNRAY

County Russell Elev.

Sec. 20 Twp. 14 Rge. 13W

Company C. W. Shaffer & Stearns Drlg.

Farm Name Opdyke No. 7

TOPS	DEPTH	LOG	DATUM
Anh.			
Tp.			
H.			
Tr.			
Dg.			
Bl.			
L.			
K.C.			
B.K.C.			
Ce.			
C.			
M.			
M.			
K.			
Mz.			
Mo.			
V.			
S.			
S.			
A			
R.			
Pe.			
G.			
TD			

Loc. in Sec. SW SE SW

Geol.

Contr. Stearns

Pool Hall-Gurney

FIRST REPORT

MAY 8 '57

Date Comm.

R U R

Co. Lse. No. Sec. T. R.

CORRECTION

FORM 513 SUNRAY

County Russell Elev. 1775

Sec. 20 Twp. 14 Rge. 13W

Company C. W. Shaffer & Stearns Drlg.

Farm Name Opdyke No. 7

TOPS	DEPTH	LOG	DATUM
Anh.			
Tp.			
H.	2848		
Tr.			
Dg.			
Bl.			
L.	2915		
K.C.			
B.K.C.			
Ce.			
C.			
M.			
M.			
K.			
Mz.			
Mo.			
V.			
S.			
S.			
A			
R.			
P€.			
G.			
T.D.	3200		

Loc. in Sec. ~~SW SE SW~~ 5252

Geol.

Contr. Stearns

Lse.

Pool Hall-Gurney

COMPLETE

JUL 31 '57

No.

Date Comm.

Sec.

RUR MAY 15 57 5-12-57 8 5/8

T.

416/200 D 2200 MAY 22 '57 DST

2950-60 Ihr rec 15' SOCM

BHT 610 D 3104 MAY 29 '57 5½ 3191

1100 JUN 5 57 JUN 12 '57 D in JUN 19 '57 JUN 26 57

JUL 3 57 JUL 10 '57 ✓ JUL 17 '57 JUL 24 '57 ✓

R.

24/2954-58 1½ /3 & 9 Boph

+ Tr. wtr. est P. 25 Bopd

+ Tr. Wtr.