

KANSAS


FORM 51 5M 11-44 PETROL

Russell County

Section 20 Township 14 Range 13W

Well No. #3 Rein

Company Jones & Shelborne

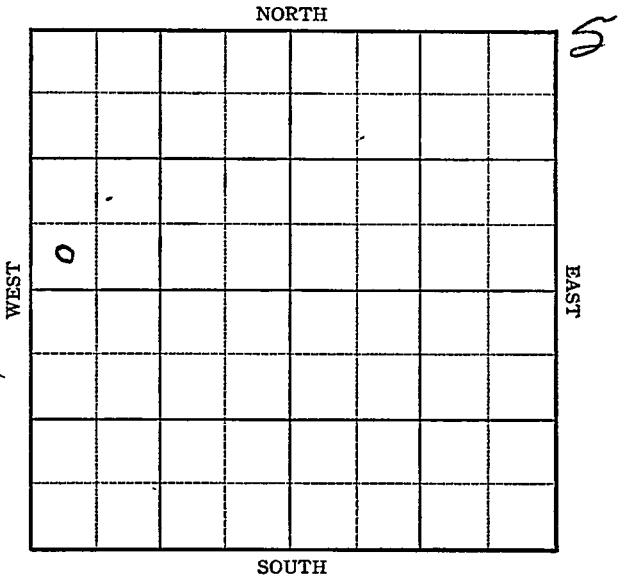

KANSAS

Sec. 20 Twp. 14 R. 13-W

Well No. ~~#2~~ ^{#3} Rein _____ Farm

Jones & Shelborne Company

Hall-Gurney


_____ Ft. from N. Line

330 Ft. from S. Line

_____ Ft. from E. Line

330 Ft. from W. Line

SW NW

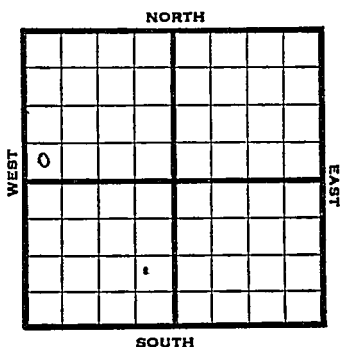

1946 1787 REPORT

- 6/19 Rig
- 6/30 Rigging up
- 7/3 Drlg 370'
- 7/9 Anhy 738'
13" @ 745
Drlg 785'
- 7/16 Drlg 1735'
- 7/23 10" @ 2023'
S Gas 2305-10
Drlg 2315'
- 7/30 8" @ 2600'
Topeka 2635
Drlg 2655'
- 8/6 Lans 2955 -
Drlg 3050'
- 8/13 Arb 3210
TD 3213 $\frac{1}{2}$
5" @ 3211-350 oil 10 hrs.
- 8/20 TD 3217
Pump 40 oil a day plus 4% wtr
- 8/27 ARb 3210'
5" @ 3211'
TD 3217'
Pump 42' oil plus 18% W Pot
39 Grav.

COMPLETED

KANSAS Kansas Pool Name Hall-Gurney Pool

Map No. 72 Sec. 20 Twp. 14 R. 13W

Well No. 2 Rein

Jones & Shelborne Company

FIRST REPORT Contractor

SW NW

SECTION PLAT

_____ Ft. from N. Line

330 Ft. from S. Line

_____ Ft. from E. Line

330 Ft. from W. Line

o			

Russell County

RECORD

Location _____

Cased _____ in, _____ ft.

Rig up _____

Sand _____

Drilling and Remarks:

Gas _____

Rig.

Oil _____

Total Depth _____

PRODUCTION

1st 24 hrs. Nat. _____

1st 24 hrs. after shot _____

Gas _____ Cu. Ft.

Dry Hole _____

Abandoned _____

Date

JUN 19 1946 19 _____

S. J. LEWIS

Scout