FORM 51


Russell KANSAS

Section 20 Township 14 Range 13W

Well No. 6 Opdycke

Company Stearns Petr.

13

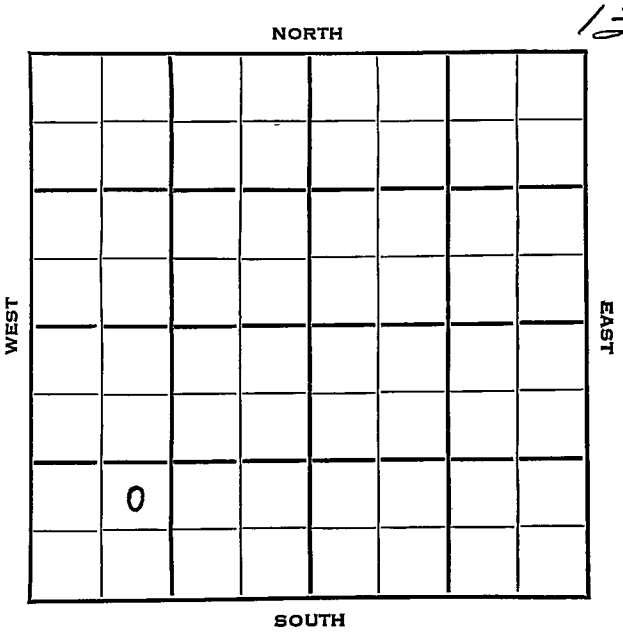

Russell KANSAS

SEC.	TWP.	R.
20	14	13 W

WELL NO.

6 Opdycke FARM

COMPANY

Stearns Pet.

CONTRACTOR

Stearns Pet.

Hall-Gurney Pool


_____ Ft. from N. Line

990 Ft. from S. Line

_____ Ft. from E. Line

990 Ft. from W. Line

NE SW SW

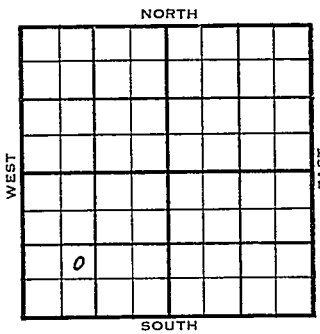

1954	ELEVATION 1781	REPORT
1/13		Spud 1-4-54 8" @ 428 Anhy 736' Core 1977-97 Core 2002-25 Drlg. 2195'
1/27		Spud 1-4-54 Oil well TD 2340 8" @ 428 Anhy 736 Tarkio 2323 TD 2340 5" @ 2340 CO to 2335 36/2323-29 3 GOPH Hydro. S/10 BOPH Comp. 25 BOPD **COMPLETED**

DX-78

FORM 275 FOR SALE BY KANSAS BLUE PRINT CO.

County Russell State Kansas

Sec. 20 (Blk. Twp.) 14 (Sur. Rge.) 13W Map No.

Operator Stearns Pet.

Well No. 6 Farm Opdycke

Elev. 1784 Location NE SW SW

FIRST REPORT

990 Ft. From S Line SW

990 Ft. From W Line Quarter

1st. Report JAN 1 3 1954

Completion

Remarks

Stearns Pet. - Contr.

Spudding Date 1-4-54

Drlg. Data Hall-Gurney Pool

8" @ 428 Anhy 736 Core 1977-97

Core 2002-25 drlg. 2195

J. G. McGEHEE

FORM 275 FOR SALE BY KANSAS BLUE PRINT CO.


County Russell State Kansas

Sec. 20 (Blk. Twp.) 14 (Sur. Rge.) 13W Map No.

Operator Stearns Pet.

Well No. 6 Farm Opdycke

Elev. 1784 Location NE SW SW

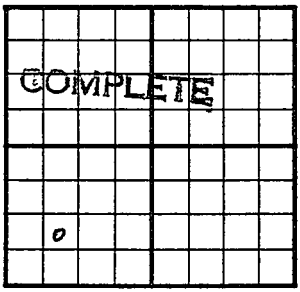

990 Ft. From S Line SW

990 Ft. From W Line Quarter

1st. Report

Completion JAN 27 1954

Remarks Hall-Gurney Pool
Stearns - Contr.

Spudding Date 1-4-54

Drlg. Data Oil well TD 2340

8" @ 428 Anhy 736 Tarkio 2323

TD 2340 5" @ 2340 CO to 2335

36/ 2323-29 3 goph Hydro. S/ 10 boph

Comp. 25 bopd

J. G. McGEHEE