

Trego

KANSAS 21W

SECTION 36 TOWNSHIP 14 RANGE _____

WELL NO. #3 O. Wagner

COMPANY Guy Atkinson

NORTH

	0						

WEST

EAST

SOUTH

Trego

KANSAS

SEC. 36	TWP. 14	R. 21W
------------	------------	-----------

WELL NO. #3 O. Wagner FARM

COMPANY Guy Atkinson

CONTRACTOR Golden Catt Groff


_____ Ft. from N. Line

_____ Ft. from S. Line

_____ Ft. from E. Line

_____ Ft. from W. Line

~~NE SW SW~~
SE NW SW

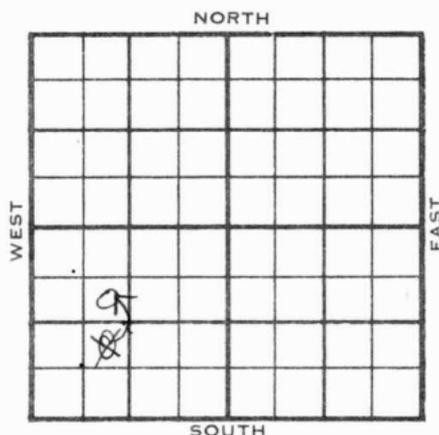

1956

ELEVATION

2069'

REPORT

4-11

Comm. 4-4-56
Drlg. 1350

5-2

8 5/8" @ 1379 w/600
DST 3745-61 op 1 hr. rec. 27' G&OCM,
700/20"
DST 3784-3817 op 1 hr. rec. 26' mud,
0/20".
DST 3815-27 op 1 hr. rec. 10' drlg.mud.
BHP Off.
D & A
Anh. 1378
H. 3370
Tr. 3390
L. 3409-74
BKC 3657
BKC 3657
Marm cht. 3742
Basl Pen 3805
A. 3841
TD 3900'

ABANDONED

County Trego Elev. _____
 Sec. 36 Twp. 14 Rge. 21W
 Company Guy Atkinson
 Farm Name O. Wagner No. 3

TOPS	DEPTH	LOG	DATUM	Loc. in Sec.
Anh.				NE SW SW
TP.				
H.				
Tr.				
Dg.				
Bl.				
L.				Geol. _____
K.C.				Contr. _____
B.K.C.				<u>Golden Catt</u>
Ce.				Pool _____
C.				<u>Groff</u>
M.				
M.				
K.				
Mz.				
Me.				
V.				
S.				
S.				
A.				FIRST REPORT
R.				
PE.				
G.				APR 11 56
TD.				

Date Comm. 4-4-56
 drlg. 1350

APR 15 1956

R. G.

Co.
Lse.
No.
Sec.
T.
R.