

Russell

KANSAS


FORM 51 5M 4-41 PETROL

Section 20 Township 14 Range 13-W

Well No: #1 Rein

Company Eldorado Refining

NORTH Hall Gurney Pool

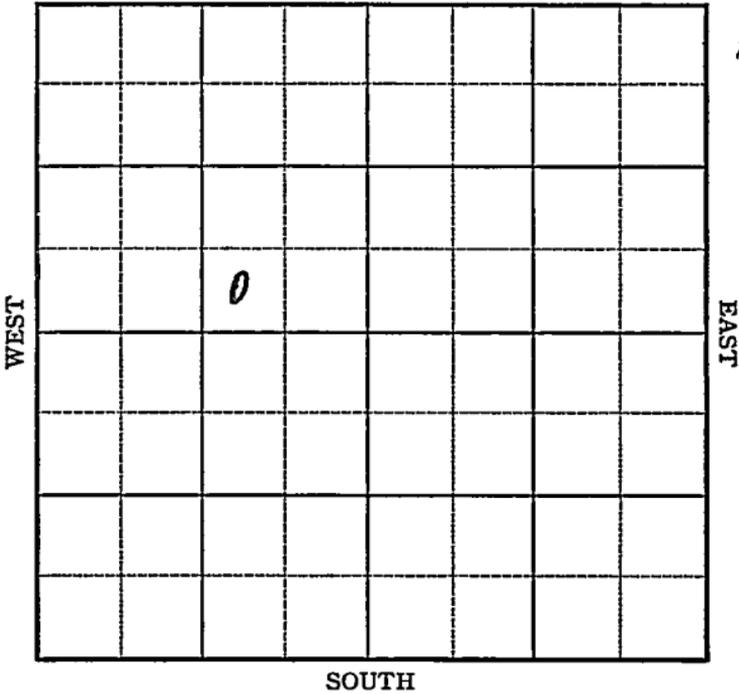

Sec. 20 Twp. 14 R. 13-W

Well No. #1 Rein Farm \_\_\_\_\_

Eldorado Refg. Company \_\_\_\_\_  
 (Hall Gurney)


\_\_\_\_\_ Ft. from N. Line

330 Ft. from S. Line

990 Ft. from E. Line

\_\_\_\_\_ Ft. from W. Line

Elev. 1838

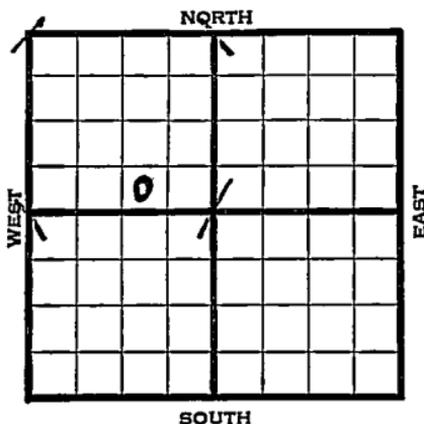

1941	REPORT
10/15	Cable.
10/23	"
10/30	Spud & SD.
11/6	" "
11/13	" "
11/19	15" - 300' Drlg. 470'
11/26	Anhy 788' 10" - 790'
	Drlg. 1560'
12/4	SSO 2345-50' T.D. 2415'
	Run 8".
12/11	8" @ 2416
	Topeka 2690
	7" @ 3010 CO.
12/17	Abb 3277
	HFN
	TD 3319
	<b>ABANDONED</b>

Russell

KANSAS

Map No. 72 Sec. 20 Twp. 14 R. 13WWell No. 1 ReinEldorado Refining CompanyABANDONED

Contractor

SW SE NW

## SECTION PLAT

	o		

\_\_\_\_\_ Ft. from N. Line

330 Ft. from S. Line990 Ft. from E. Line

\_\_\_\_\_ Ft. from W. Line

## HALL GURNEY POOL

Location \_\_\_\_\_

Rig up \_\_\_\_\_

Drilling and Remarks:

*Cor 83277**YFV*

## RECORD

Cased \_\_\_\_\_ in., \_\_\_\_\_ ft.

Sand \_\_\_\_\_

Gas \_\_\_\_\_

Oil \_\_\_\_\_

Total Depth 3319

## PRODUCTION

1st 24 hrs. Nat. \_\_\_\_\_

1st 24 hrs. after shot \_\_\_\_\_

Gas \_\_\_\_\_ Cu. Ft.

Dry Hole \_\_\_\_\_

Abandoned \_\_\_\_\_

Date

DEC 17 1941 19S. J. LEWIS Scout

