

# KANSAS

Russell

FORM 51 25M 3-49 PETROL

Section 20 Township 14 Range 13-W

Well No. #3 Rein

Company Eldorado Ref.  
Hall-Gurney Pool

NORTH

WEST

EAST

SOUTH

0							

4

Russell **KANSAS**

Sec. 20 Twp. 14 R. 13W ✓

Well No. #3 Rein Farm

Eldorado Refg.

Company


Hall-Gurney Pool (Williams, Contr.)

330' Ft. from N. Line

\_\_\_\_\_ Ft. from S. Line

\_\_\_\_\_ Ft. from E. Line

330' Ft. from W. Line

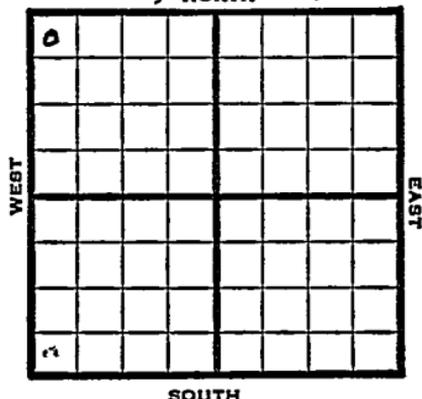

NW/C

1949

Ele<sub>v</sub> 1803'

**REPORT**

11/30

Location

12/8

8" @ 339'  
 Drlg 2200'

12/14

Lansing 2956' Arbuckle 3226'  
 TD 3231' 5" @ 3228'

12/21

"

12/28

"

1950

1/18

TD 3340'  
 8" @ 339'  
 5" @ 3228'  
 Salt wtr. disposal well  
 Tops:  
 Anhy 780'  
 Lans 2956'  
 Arb. 3226'  
 Aband.

**ABANDONED**

Map No. \_\_\_\_\_ Sec. 20 Twp. 14 R. 13W

Well No. 3 Rein

\_\_\_\_\_ Eldorado Ref. \_\_\_\_\_ Company

\_\_\_\_\_ Williams \_\_\_\_\_ Contractor

NW/C

**FIRST REPORT  
SECTION PLAT**

330 Ft. from N. Line

\_\_\_\_\_ Ft. from S. Line

\_\_\_\_\_ Ft. from E. Line

330 Ft. from W. Line

<sup>0</sup>			

Russell County

Location X

Rig up \_\_\_\_\_

Drilling and Remarks:

**RECORD**

Cased \_\_\_\_\_ in., \_\_\_\_\_ ft.

Sand \_\_\_\_\_

Gas \_\_\_\_\_

Oil \_\_\_\_\_

Total Depth \_\_\_\_\_

**PRODUCTION**

1st 24 hrs. Nat. \_\_\_\_\_

1st 24 hrs. after shot \_\_\_\_\_

Gas \_\_\_\_\_ Cu. Ft.

Dry Hole \_\_\_\_\_

Abandoned \_\_\_\_\_

Date

NOV 30 1949 19

S. J. LEWIS Scout

Kansas

Map No. \_\_\_\_\_ Sec. 20 Twp. 14 R. 13W

Well No. 3 Rein

Eldorado Ref. \_\_\_\_\_ Company

Contractor

NW/C


E.L. 1803  
SECTION PLAT

330 Ft. from N. Line

\_\_\_\_\_ Ft. from S. Line

\_\_\_\_\_ Ft. from E. Line

330 Ft. from W. Line

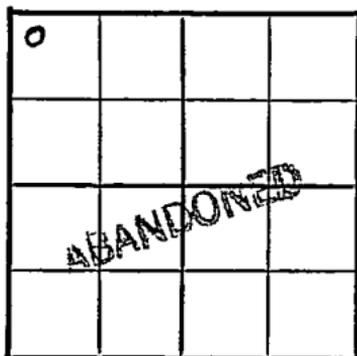

Russell County

Location \_\_\_\_\_

Rig up \_\_\_\_\_

Drilling and Remarks:

8" @ 339

5" @ 3228

Salt Water

Disposal Well  
(tops over)

Date

JAN 18 1950

## RECORD

Cased \_\_\_\_\_ in., \_\_\_\_\_ ft.

Sand \_\_\_\_\_

Gas \_\_\_\_\_

Oil \_\_\_\_\_

Total Depth 3340

## PRODUCTION

1st 24 hrs. Nat. \_\_\_\_\_

1st 24 hrs. after shot \_\_\_\_\_

Gas \_\_\_\_\_ Cu. Ft.

Dry Hole \_\_\_\_\_

Abandoned \_\_\_\_\_

J. E. TYRA

Scout