COPY 100

FORM 55-38 BKS-8-28-CROMAC

OKLAHOMA NATURAL GAS CORPORATION

RECORD OF WELL. Serial No. ~~1568~~ 1626 Oil, Gas or Dry? Oil

Central Field Kansas Okla., , 192

Located on lands of Beckie Rosier Farm No. 1 Section 27 Township 28 Range 18E

Canville Township Neosho County. Location of Well Feet N-S

of and feet, E-W of Elevation Feet

Commenced , 19 Completed , 192

Drilling Contractor Rock Pressure lbs. Shut-in Hours

Test inches (Mercury / Water) inch (Orifice / Tube) Volume Thru Casing Ft. in 24 Hours

Test inches (Mercury / Water) inch (Orifice / Tube) Volume Thru Casing Ft. in 24 Hours

(NOTE—The above tests to be taken after the well is packed or capped.)

Shot Quarts Length of Shell Depth Top of Shot feet. Initial Production

Shot Quarts Length of Shell Depth Top of Shot feet. Bbls. Oi

Drive Pipe or Conductor—Kind		Size	10"	No. of Ft.	11	Inches		
Casing, No. Joints	Weight	"	6¼"	"	760	"		
Casing, " "	"	"		"		"		
Casing, " "	"	"		"		"		
Tubing, " "	"	"	2"	"	825	"		
Tubing, " "	"	"		"		"		
Tubing, " "	"	"		"		"		
Anchor, " "	"	"		"		"		
Rods or Wire Line		"		"		"		

Packer—Style Make Size Set at

Packer—Style Make Size Set at

Drive Shoe R. & L. Nipple set at Size Check Coupling set at

LOCATE WELL CORRECTLY

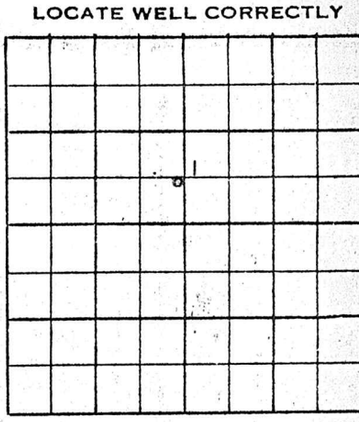

Depth of Well Feet @ $ Was Gas Used for Fuel?

Depth of Water Well Feet @ $ By Meter or Day?

Reamed Feet @ $ Meter, Kind? Number

Last State

Condition of Gas—Wet or Dry? State When Set

Type of Drilling Rig? Cubic Feet Passed

Total Cubic Feet Passed @ lbs. Pressur

Formation Record	Top	Bottom	Depth Where Flow Occurs	*Quantity Gas, Oil or Water	Formation Record	Top	Bottom	Depth Where Flow Occurs	*Quantity Gas, Oil or Water
Soil	0	8			825' of 5/8" Iron Sucker Rods				
Sand	8	18			2' of 2" Perforated Pipe				
Shale & Lime	18	316			1 2" x 6" Working Barrel				
Shale	316	410			1 1¾" Working Valve				
Lime	410	422			1 1¼" Standing Valve				
Shale	422	496			1 6¼" x 2" x 2" N.S.Co. Casinghead				
Lime	496	544			1 2" x 10" Nipple				
Shale	544	588			1 2" Collar				
Lime	588	610			1 2" C I Plug				
Shale	610	615			1 2" Mallable Tee				
Lime	615	621			1 2" x 4" Nipple				
Shale	621	760			1 2" x 7" Nipple				
Sand Oil	760	770			1 2" x 1-1/8" N.S.Co. C I Flange Stuff Box Fem.				
Shale	770	785			1 1-1/8" x 11' Steel Polishing Rod				
Sand Oil	785	825			1 1-1/8" Steel Polishing Rod Clamp				
Shale Black	825	917			1 N.S.Co. Wooden Pumping Jack Complete				
					2 2" x 8" x 10' long pump jack anchor				
					2 Hedge Posts 4' long used as pump jack anchors				
					BOTTOM OF HOLE	****			

NOTE. *If increase occurs in any sand repeat name of sand and show increased flow in "Quantity" column, gas in cubic ft. (or gauge reading,) oil and water in gallons. This test should be taken soon after gas, oil or water appears. If gas blows out, so state in remarks.

REMARKS:

FOREMAN SUPERINTENDEN

White to Engineer, Yellow to Accounting Dept., Blue to Land Dept., Green to Superintendent, Pink retained by Foreman.))