


Ellis

KANSAS

SECTION 28 TOWNSHIP 14 RANGE 20W

WELL NO. #1 Fisher

COMPANY Herman Geo. Kaiser

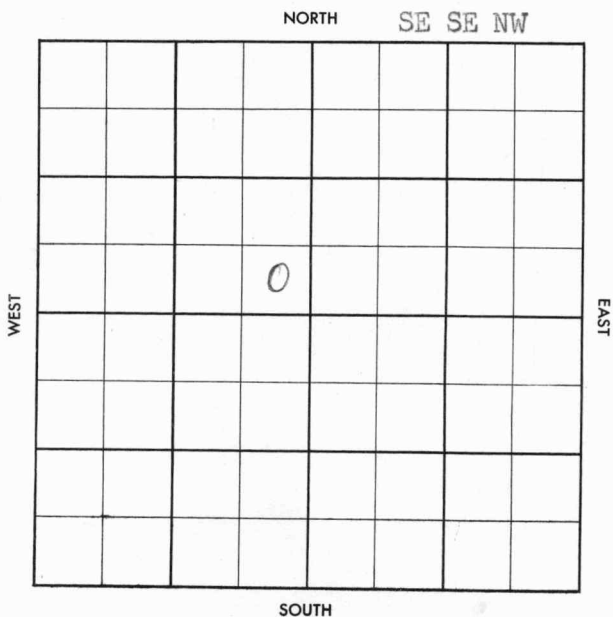

WILDCAT

FORM 513 SUNRAY

County Ellis Elev. _____
 Sec. 28 Twp. 14 Rgs. 20W
 Company Herman Geo. Kaiser
 Farm Name Fisher No. 1

TOPS	DEPTH	LOG	DATUM	Loc. in Sec.
Anh.				SE SE NW
Tr.				
H.				
Tr.				
Dg.				
Bl.				
L.				Geol. _____
K.C.				Contr. _____
B.K.C.				
Ce.				<u>Armer Drlg</u>
C.				
M.				Pool _____
M.				<u>Wildcat</u>
K.				
Mz.				
Me.				
V.				
S.				
S.				
A.				
R.				
Pe.				
G.				
T.D.				

~~FIRST REPORT~~
 JUN 5 '57

Date Comm. 6-3-57 Gulf (DHM) Mag. (Ac)
 8" @ 255/150, WOC


A

Co. Lse. No. Sec. T. R.

County Ellis Elev. 2101
 Sec. 28 Twp. 14 Rge. 20W
 Company Herman Geo. Kaiser
 Farm Name Fisher No. 1

TOPS	DEPTH	LOG	DATUM
Anh.	1378		
TP.			
H.	3345		
Tr.	3367		
Dg.			
Bl.			
L.	3386		
K.C.			
B.K.C.			
C.	Marm chert 3690		
G.	3254		
M.	cgsd 3769		
M.			
K.			
Mz.			
Mq.			
V.			
S.			
S.			
A.	3783		
R.	3795		
PE.			
G.			
TD.	3815		

Loc. in Sec. SE SE NW
 Geol. _____
 Contr. Armer Drlg
 Pool Wildcat

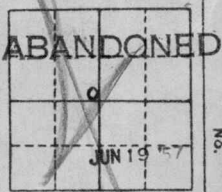

Date Comm. 6-3-57 Gulf (DHI) Mag. (Ac)
 8" @ 255/150, WOC JUN 12 57 @ 3400 JUN 19 57

X DST 3430-60 1hr run 45' MW
 FPO BHP 650/15" DST 3530-60
 1hr? 60' GIP run 30' 50 CM FT
 o BHP 0/15" Marm chert 3690
 @ 3715"

DCA

Co.
 Use.
 No.
 Sec.
 T.
 R.