


Section 20 Township 14 Range 13W

Well No. #1 Rein "F"

Company Murfin Drlg.

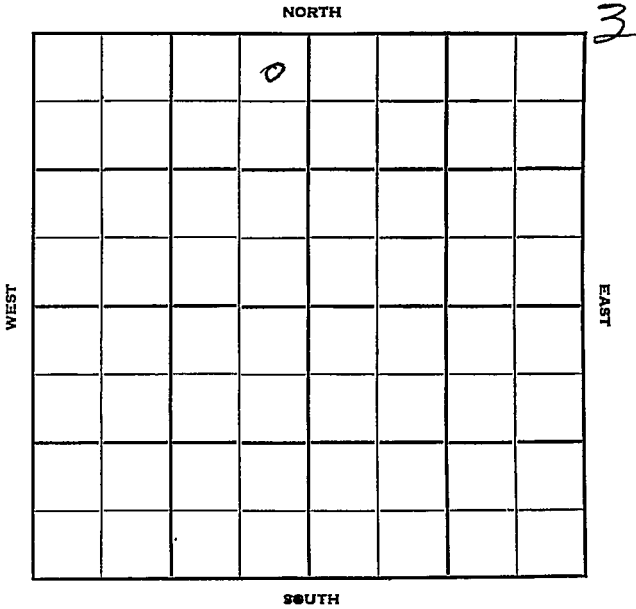

Russell

KANSAS ✓

Sec. 20 Twp. 14 R. 13W

Well No. #1 Rein "F" Farm

Murfin Drlg. Company

Murfin Drlg. -Contr. Contractor

Homer Pool


330' Ft. from N. Line

\_\_\_\_\_ Ft. from S. Line

330' Ft. from E. Line

\_\_\_\_\_ Ft. from W. Line

NE NE NW

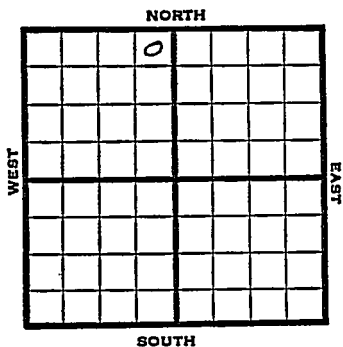

1951 Elev. 1873' REPORT

6/6 Cellar & pits

8/8 Spud 6-18-51  
 Oil Well TD 2420  
 12" @ 529 10" @ 835  
 Tarkio 2411  
 7" @ 2411  
 TD 2420 GO to 2417  
 Hydrafrac S/5 boph  
 Comp. 25 bopd

**COMPLETED**



County Russell State Kansas

Sec. 20 (Blk. 14) (Sur. 13W) (Twp.) (Rge.) Map No.

Operator Murfin Drlg.

Well No. 1 Farm Rein "F"

Elev. 1873 Location NE NE NW

		o			

330 Ft. From N Line NW

330 Ft. From E Line Quarter

Ist. Report

Completion AUG 8 1951

Remarks Homer Pool

Murfin Drlg. - Contr.

Spudding Date 6-18-51

**COMPLETE**

Drlg. Data Oil well TD 2420

12" @ 529 10" @ 835 Anhy 825

Tarkio 2411 7" @ 2411 TD 2420

CO to 2417 Hydrofrac S/ 5 boph

Comp. 25 bopd