


Map No. KANSAS Sec. 1 Twp. 14 R. 21WWell No. 1- Lang Farm
Kaura & Hauck Company

NORTH

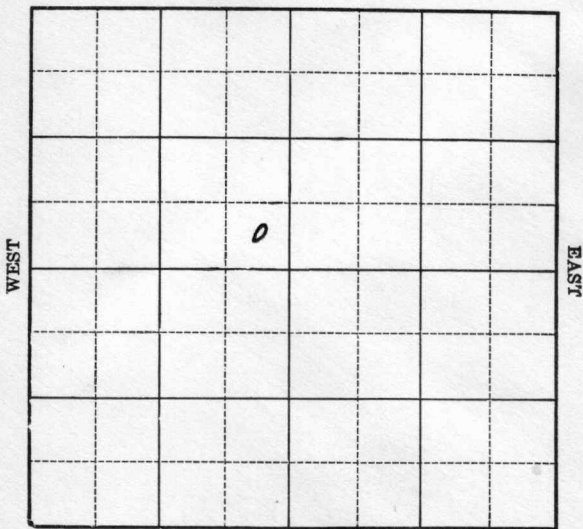

SOUTH

Location _____

Drilling Remarks _____

Rig Up _____

Drilling Remarks _____

RECORD

Cased _____ in. _____ ft.

Sand _____

Gas _____

Oil _____

Total Depth _____

PRODUCTION

1st 24 hrs. Nat. _____

1st 24 hrs. after shot _____

Gas _____ cu. ft. _____

Dry Hole _____

Abandoned _____

Supo
21 W

Map No. _____ Sec. *14* Twp. *14* R. _____

Well No. *1 - Lang* Farm _____

Hanna & Hauck Company _____


_____ Ft. from N. Line

330 Ft. from S. Line

330 Ft. from E. Line

_____ Ft. from W. Line

2221?

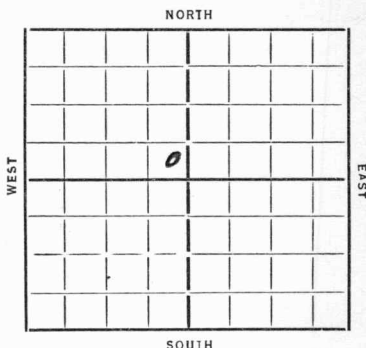

Date

REPORT

1935
3/6 *Call*
3/14 *— 3/21 — 3/28 — 4/4 —*
4/11 _____
4/18 *Rig*
4/26 *— 5/2 — 5/9 — 5/16 —*
5/23 *Moving*
5/29 *Spud*
6/6 *Dlg 1975 15 1/2 170*
6/13 *" 2760 3280*
6/20 *Topeka 3296 3314 log*
6/28 *— 7/3 —*
7/11 *Topeka 3280*
7/18 *Coring 3285*
7/18 *8" 3589 Rust*
7/18 *3645 pull 6"*
8/15 *log 3645*
8/22 *— 8/29 — 9/6 —*
10/3 *BHC 3741 6" 3670*
10/3 *rw 3715*
10/10 *Dlg 3830*
10/10 *6" 3745 3827 UR 6"*

(OVER)

10/21 Top siliceous lime 3898
Good show oil
Running hole down (2el)

11/1 Recementing 7"

11/7 Sg 3992 HFW 3917-20

11/14 —

11/20 Reagan 4096
TD 4134

D. & A.

ABANDONED

Map No. 70 Sec. 1 Twp. 14 R. 31WWell No. 1- LangHansa + Lauck Company

Contractor


FIRST REPORTS

SECTION PLAT

Ft. from N. Line

330 Ft. from S. Line330 Ft. from E. Line

Ft. from W. Line

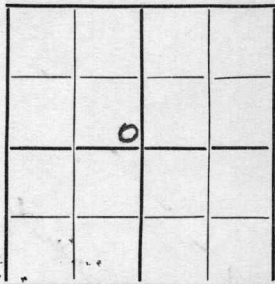

Location

Rig up

Drilling and Remarks:

cellar

RECORD

Cased _____ in., _____ ft.

Sand _____

Gas _____

Oil _____

Total Depth _____

PRODUCTION

1st 24 hrs. Nat. _____

1st 24 hrs. after shot _____

Gas _____ Cu. Ft.

Dry Hole _____

Abandoned _____

Date

3-6-35 192

ORVAL MANNSCHRECK

Scout

Map No. 70 Sec. 1 Twp. 14 R. 21WWell No. 1 - LangHansa + Lauck Company

Contractor

ABANDONED

SECTION PLAT

	0		

Ft. from N. Line

330 Ft. from S. Line330 Ft. from E. Line

Ft. from W. Line

Location

Rig up

Drilling and Remarks:

10 + A

RECORD

Cased Regan 4096 in., ft.

Sand

Gas

Oil

Total Depth 4134

PRODUCTION

1st 24 hrs. Nat.

1st 24 hrs. after shot

Gas Cu. Ft.

Dry Hole

Abandoned

Date

ORVAL MANNSCHRECK

11-20-35 192 Scout