

DX 78-1


Trego

KANSAS

Section 5 Township 14S Range 21W

Well No. #1 Flak

Company Welch & Olsson

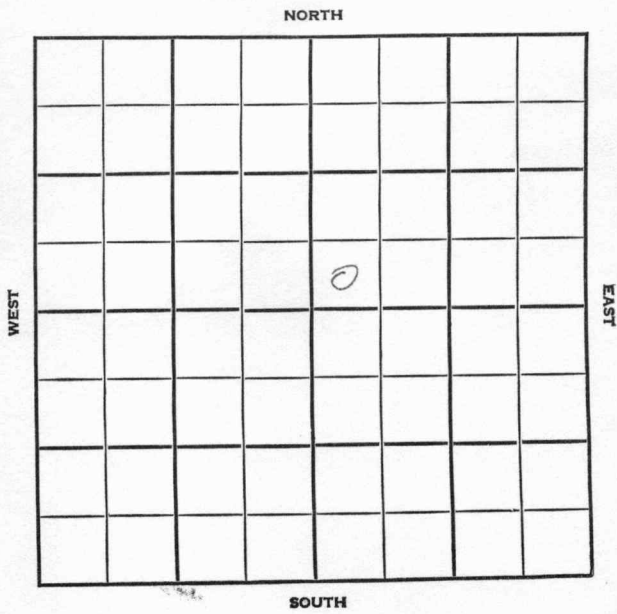

Trego

KANSAS

SEC. 5-	TWP. 14	R. 21W
------------	------------	-----------

WELL NO. #1 Flax

COMPANY Welch & Olsson

CONTRACTOR Co.


Locker

_____ FT. FROM N. LINE

_____ FT. FROM S. LINE

_____ FT. FROM E. LINE

_____ FT. FROM W. LINE

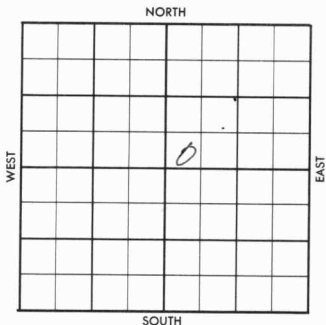

SW SW NE

1956	ELEVATION 2244'	REPORT
------	--------------------	--------

- 8-8 8" @ 190 w/175
MIRT
- 8-13 Drlg. 3615'
- 8-23 Lans. 3602'; BKC 3851'; Marm 3864';
Marm chert 3946'; Cong sd 3998';
TD 4265';
D & A
Holding ticket for DST.
- 8-29 Comm. ~~8-7-56~~ 8-7-56
DST 3987-4030 op 30 min. rec. 15' mud,
All press. 0#.
D & A
TD 4265'

ABANDONED

County Trego Elev. _____
 Sec. 5 Twp. 14S Rge. 21W
 Company Welch & Olsson
 Farm Name Flax No. 1

TOPS	DEPTH	LOG	DATUM	Loc. in Sec.
Anh.				SW SW NE
Tp.				
H.				
Tr.				
Dg.				
Bl.				
L.				Geol. _____
K.C.				Contr. _____
B.K.C.				Co. _____
Ce.				
C.				
M.				Pool _____
M.				Locker _____
K.				
Mz.				
Me.				
V.				
S.				
S.				
A.				
R.				
Pe.				
G.				
T.D.				

FIRST REPORT
 0

Date Comm. AUG 8 '56
8" 190 w/175 sx; MIRT

(Large handwritten scribble, possibly '5/')

County Trego Elev. 2244
 Sec. 5 Twp. 14S Rge. 21W
 Company Welch & Olsson
 Farm Name Flax No. 1

Co.

	DEPTH	LOG	DATUM	Loc. in Sec.
				SW SW NE
Tr.				
Dg.				
Bl.				
L.	3602			Geol.
K.C.				Contr.
B.K.C.	3851			Co.
Ce.	Marm 3864			Pool
C.	" ch 3946			Locker
M.	ca sd 3998			ABANDONED
M.				
K.				1/2 mile
Mz.				
Me.				AUG 29 1956
V.				
S.				
S.	4033			
A.				
PE.				
G.				
TD.	4265			

Sec.

No.

Sec.

T.

R.

Date Comm. 8-7-56
8" 190 w/175 sx; MIRT AUG 15 '56
AUG 22 '56 1 DST AUG 29 '56 DST 3987
-4030 30" sec 15' Md AH
Press 0

D&A