


Section 20 Township 14 Range 13 W

Well No. # 3 Rien "F"

Company Murfin Drlg.

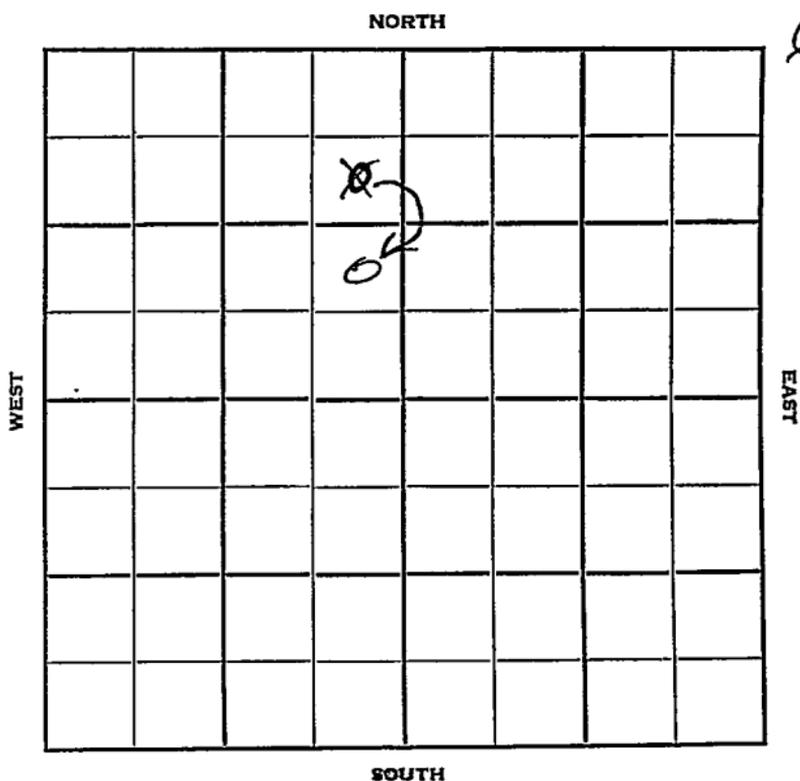



Sec. 20 Twp. 14 R. 13 W

Well No. # 3 Rien "F"

Murfin Drlg.

Company

Contractor


990 Ft. from N. Line

990 Ft. from S. Line

330 Ft. from E. Line

Ft. from W. Line

NE SE NW
SE NE NW

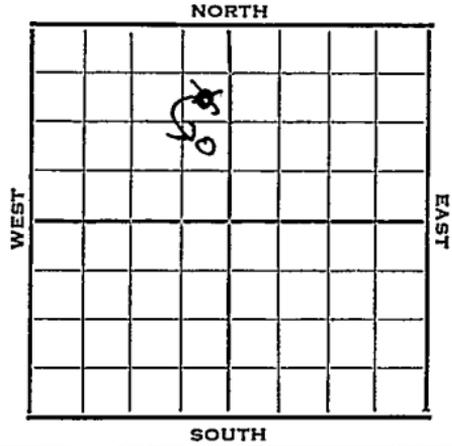

1952

Elev. 1846' REPORT

9/4 Cellar & Pits

9/10 Drlg. 50'

9/17 10" @ 503' Anhy 788'
8" @ 795 Drlg. 975'

9/24 Drlg. 1915'

10/1 Tarkio 2384
7" @ 2384

TD 2394'

10/8 Hydf.

10/15 S/3 BOPH

10/22 Spud 9-8-52

Oil Well

T^u 2394'

10" @ 503'

Anhy 788'

8" @ 795

Tarkio 2384

7" @ 2384'

TD 2394' Hydro. S/3 bo 1 day Hydro.

S/3 boph

Comp. 25 bopd

COMPLETED

County Russell State Kansas

Sec. 20 (Blk.) 14 (Sur.) 13W Map No.

Operator Murfin Drlg.

Well No. 3 Farm Rein "F"

Elev. 1846 Location NE SE NW

		0			
		COMPLETE			

990 Ft. From S Line NW

330 Ft. From E Line Quarter

1st. Report

Completion OCT 22 1952

Remarks

Spudding Date 9-8-52

Drlg. Data Oil well TD 2394

10" @ 503 Anhy 788 8" @ 795

Tarkio 2384 7" @ 2384 TD 2394

Hydro. S/ 3 bo 1 day Hydro.

S/ 3 boph Comp. 25 bopd

Map No. _____ Sec. 20 Twp. 14 R. 13W

Well No. 3 Rein "F"

Murfin Drlg. _____ Company

~~CORRECTION~~ _____ Contractor

NE SE NW

SECTION PLAT

_____ Ft. from N. Line

990 Ft. from S. Line

330 Ft. from E. Line

_____ Ft. from W. Line

	o		

Russell County

RECORD

Location _____

Cased _____ in., _____ ft.

Rig up _____

Sand _____

Drilling and Remarks:

Gas _____

Reported

Oil _____

SE NE NW

Total Depth _____

PRODUCTION

1st 24 hrs. Nat. _____

1st 24 hrs. after shot _____

Gas _____ Cu. Ft.

Dry Hole _____

Abandoned _____

Date

SEP 17 1952 19

J. G. McGEHEE

Scout