

Section 12 Township 14 Range 21 W

Well No. # 1 Luea

Company Brunson Drlg. Co.

NORTH

WEST

EAST

							0

SOUTH

Trego

KANSAS

Sec. 12 Twp. 14 R. 21W

Well No. #1 Luea Farm

Brunson Drlg. Co. Company

Wildcat Contractor


Ft. from N. Line

330' Ft. from S. Line

330' Ft. from E. Line

Ft. from W. Line

SE SE SE

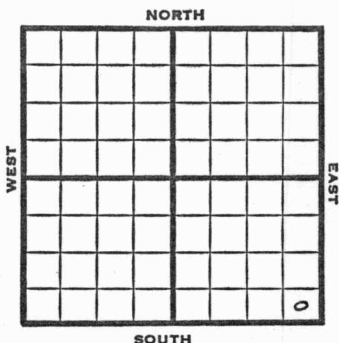

1951

Elev. 2207'

REPORT

6/27

Location

7/11

Spud 6-26-51

D&A TD 3980

8" @ 161

Heeb. 3484 Tor. 3502


Lans. 3527 BKC 3769

Mar. 3841 Cong. 3905

Arb. 3939- TD 3980

D&A

ABANDONED

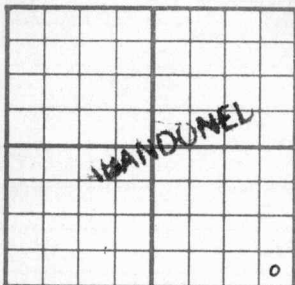County Trego State KansasSec. 12 (^{Blk.}_{Twp.}) 14 (^{Sur.}_{Rge.}) 21W Map No.Operator Brunson Drlg.Well No. 1 Farm LueaElev. 2207 Location SE SE SE330Ft. From S Line SE330Ft. From E Line QuarterIst. ReportCompletion JUL 11 1951Remarks WildcatSpudding Date 6-26-51Drlg. Data D & A TD 39808" @ 161 Heeb. 3484 Tor. 3502Lans. 3527 B KC 3769 Mar. 3841Cong. 3905 Arb. 3939-80 TDD & A

J. E. TYRA