

Section 17 Township 14 Range 21W

Well No. #1 Madden

Company Rine Drlg. et al

NORTH

				0			

WEST

EAST

SOUTH

Sec. 17 Twp. 14 R. 21W ✓

Well No #1 Madden Farm

Rine Drlg. et al Company

Atkins Drlg. -Contr. Contractor

Wildcat


330' Ft. from N. Line

\_\_\_\_\_ Ft. from S. Line

\_\_\_\_\_ Ft. from E. Line

330' Ft. from W. Line

NW NW NE

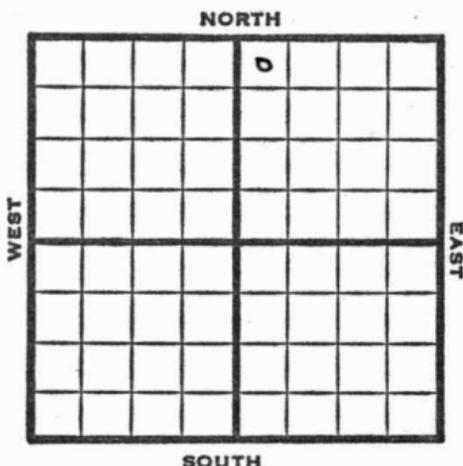

1951 Elev. 2183' REPORT

6/6 Spud 6-3-51  
10" @ 197'  
WOC

7/11 Spud 6-3-51  
D&A TD 4351  
10" @ 197 Ft. Riley 2335  
K C 3566  
DST 3640-52 opn 1 hr Rec. 205' sw  
Top. 3270  
DST 3897-3939 opn 1 hr Rec. 120'  
o& gcm DST 3948-90 opn 1 hr Rec.  
825' sw & mud Arb. 3997  
DST 4005-50 opn 1/2 hr Rec. 30' mud  
TD 4351 5" @ 4064  
17/3971-77 Rec. 100' wtr SP 3960  
72/3909-39 SSO 500 A  
B/4-5 bwph Hydrafrac no inc.  
2 bwph SSO 24/3800-11 inc.  
in water D&A

**ABANDONED**



County Trego State Kansas

Sec. 17 (<sup>Blk.</sup><sub>Twp.</sub>) 14 (<sup>Sur.</sup><sub>Rge.</sub>) 21W Map No.

Operator Rine Drlg. etal.

Well No. 1 Farm Madden

Elev. 2183 Location NW NW NE



330Ft. From N Line NE

330Ft. From W Line Quarter

Ist. Report

Completion JUL 11 1951

Remarks Wildcat

Atkins Drlg. - Contr.

Spudding Date 6-3-51

Drlg. Data D & A TD 4351

10" @ 197 Ft. Riley 2335 KC 3566

DST 3640-52 open 1 hr. Rec. 205' sw

Top. 3270 DST 3897-3939 open 1 hr.

Rec. 120' o & gem DST 3948-90

open 1 hr. Rec. 825' sw & mud

Arb. 3997 DST 4005-50 open 1/2 hr.

Rec. 30' mud TD 4351 5" @ 4064

17/ 3971-77 Rec. 100' water SP 3960

72/ 3909-39 SSO 500 A

B/ 4-5 bwph Hydrofrac no inc.

2 bwph SSO 24/ 3800-11 inc. in wat

D & A

**J. E. TYRA**