


Section 20 Township 14 Range 13W

Well No. #2 Rein "F"

Company Murfin Drlg.

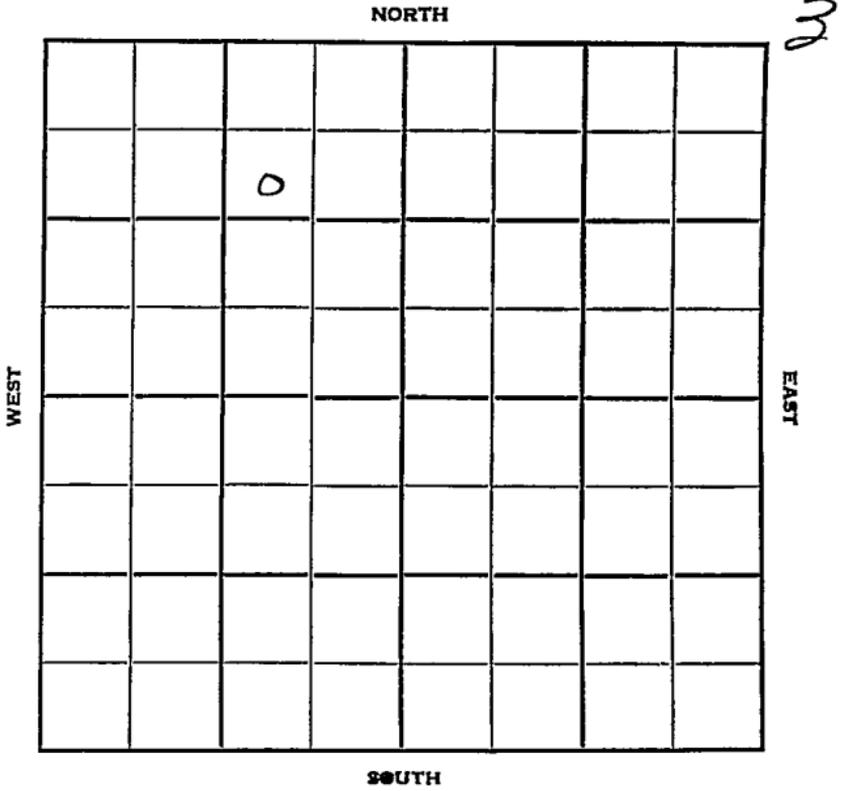

Sec. 20 Twp. 14 R. 13W

Well No. #2 Rein "F" Farm

Murfin Drlg. Company


Murfin Drlg. - Contr. Contractor
Hall-Gurney Pool

990' Ft. from N. Line

Ft. from S. Line

990' Ft. from E. Line

Ft. from W. Line

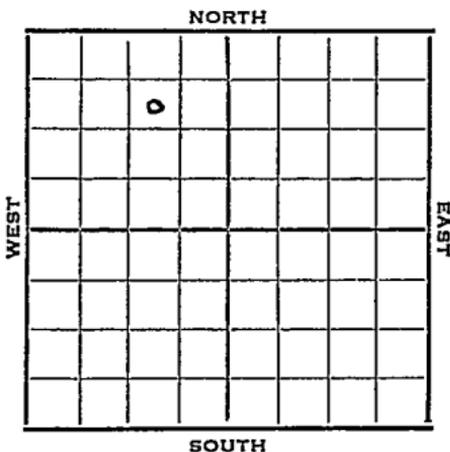

SW NE NW

1951 Elev. 1845' REPORT

12/12 Location

1952
2/6 POP

2/13 Spud 1-5-52
Oil Well TD 2405
10" @ 493 8" @ 800
Anhy 802 Tar 2370
5" @ 2399 TD 2405
S/ 5 boph
Comp. 50 bopd

COMPLETED

County Russell State Kansas

Sec. 20 (Blk. Twp.) 14 (Sur. Rgd.) 13W Map No.

Operator Murfin Drlg.

Well No. 2 Farm Rein "F"

Elev. 1845 Location SW NE NW

	0				

990 Ft. From N Line NW
 990 Ft. From E Line Quarter

Ist. Report

Completion FEB 13 1952

Remarks Hall-Gurney Pool
Murfin Drlg. - Contr.

Spudding Date 1-5-52

Drlg. Data Oil well TD 2405

10" @ 493 8" @ 800 Anhy 802

Tarkio 2370 5" @ 2399 TD 2405

S/ 5 boph Comp. 50 boph

