


KANSAS

FORM 51 IOM 12-46 PETROL

Section 20 Township 14 Range 13-W

Well No. #1 Rogg "C"

Company R. H. Shields
Hall-Gurney

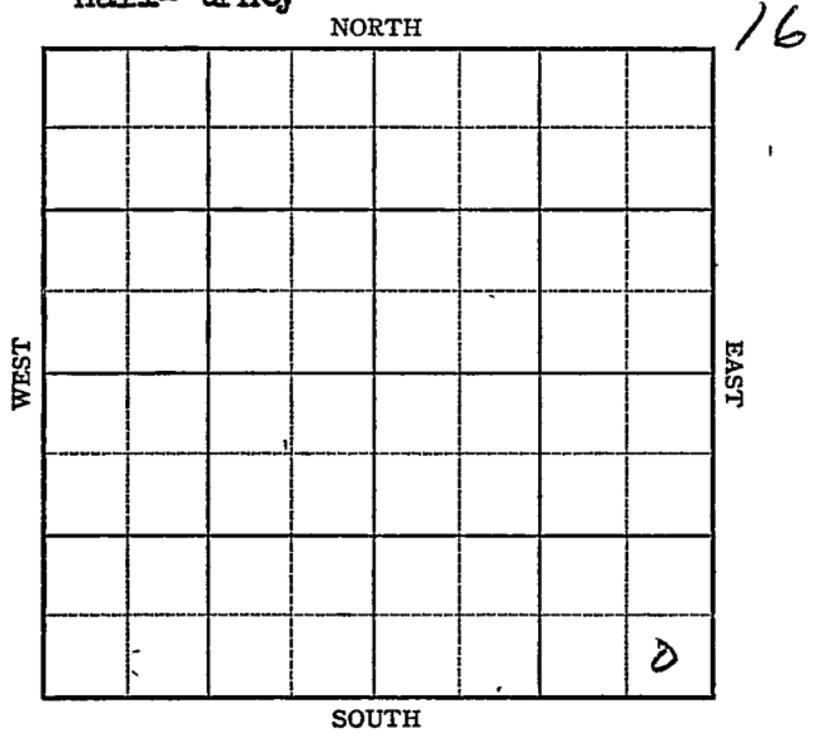

Sec. 20 Twp. 14 R. 13-W


Well No. #1 Rogg "C" Farm

R. H. Shields

Company

Hall-Gurney

NORTH

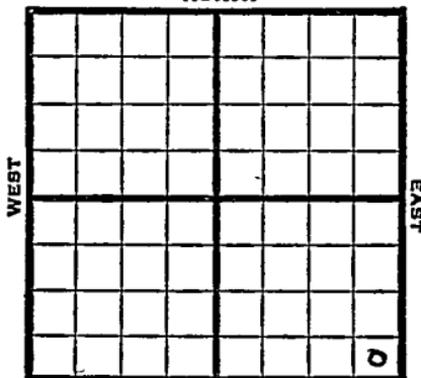

_____ Ft. from N. Line

330 Ft. from S. Line

330 Ft. from E. Line

_____ Ft. from W. Line

SE/C

Elev. 1766'

REPORT

1947

6/11 15" @ 115'
Drlg 340'

6/17 10" @ 723
Drlg 933'

6/24 Drlg 1680'

7/1 Drlg 2250'
SSo & Gas 1670-80

7/8 Tarkio 2275'
8" @ 2330'
TD 3438
900' oil 12 hrs.

7-16 TD 2500
8" @ 2485

7/22 8" @ 2579'
Topeka 2605'
Drlg 2648'

7/29 SD

8/6 Topeka 2605'
8" @ 2579'
Drlg 2648'

8/13 Drlg. 3059'

OVER

Map No. _____ Sec. 20 Twp. 14 R. 13

Well No. 1 Rogg "C"

R. H. Shields Company

FIRST REPORT Contractor

SE/C

SECTION PLAT

_____ Ft. from N. Line

330 Ft. from S. Line

330 Ft. from E. Line

_____ Ft. from W. Line

			0

Russell County

Location _____

Rig up _____

Drilling and Remarks:

15" @ 115

drlg. 340

RECORD

Cased _____ in., _____ ft.

Sand _____

Gas _____

Oil _____

Total Depth _____

PRODUCTION

1st 24 hrs. Nat. _____

1st 24 hrs. after shot _____

Gas _____ Cu. Ft.

Dry Hole _____

Abandoned _____

Date

JUN 11 1947 19

S. J. LEWIS Scout

1947
8/20 Gorham 3196 TD
8/27 HFW 3200-03 /
5" @ 3196'
Drlg. 3260'
9/3 Granite 3260
TD 3262
PB: 2866- 6 shots 2370- 7500
9/10 "
9/17 "
9/24 34 shots. 2289-94'
3000 acid.
10/1 Pump 35 bbls. oil 8 hrs.
10/8 "
10/15 "
10/22 "
10/29 Pankioa 2275'
Granite 3260'
Perf. Tarkio
3000 Acid
Pump 30 oil / 12 water
Pot
TB 3262'
Gravity 39

COMPLETED