


Section 21 Township 14 Range 21W

Well No. #5 Zeman

Company Deep Rock

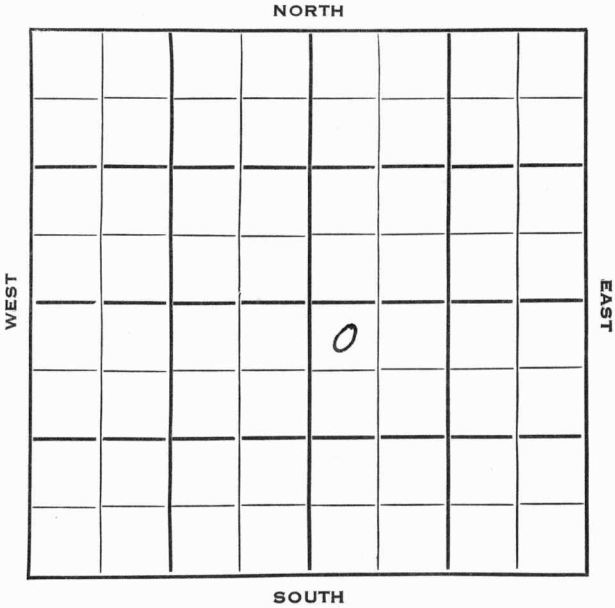

Sec. 21 Twp. Trego 14 KANSAS R. 21W

Well No. #5 Zeman Farm

Deep Rock Company


G-M-R Contractor

330 Ft. from N. Line

 Ft. from S. Line

 Ft. from E. Line

330 Ft. from W. Line

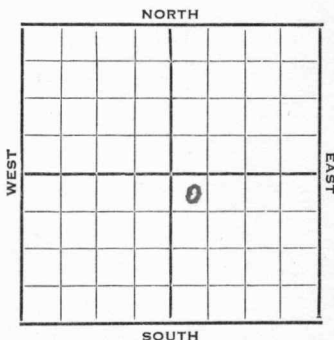

NW NW SE

1953 Elev. 2148' REPORT

7/8 Spud 7-5-53
8" @ 236
Drlg. 1785'

7/22 NR

8/26 Spud 7-5-53 Oil well TD 3938
8" @ 236 Anhy 1490 Heeb 3442
Tor. 3460 Lans 3478 B KC 3728
Marm. 3821 Zeeman sd. 3871
DST 3882-3904 open 1 hr rec 510' MCO
60' mud, 60' SW 255# Arb. 3928
TD 3938' 5" @ 3936 16/3880-84
5 GW 5 GO B/10 BO 12 GW
S/8 BO 12 hr. 250 A S/23 BO 12 hr.
st-frac. S/1 1/2 BFP 75% wtr. CO to
3892 8/3880-82 30 GFPH 66% wtr.
S/8 BO 5 BW 20 hr. S/20 BF 24 hrs.
50% wtr.
Comp. 133 BOPD 5% wtr.

COMPLETED

County Trego State Kansas
 Sec. 21 (Blk. 14) (Sur. 21W) Map No. 21W
 Operator Deep Rock
 Well No. 5 Farm Zeman
 Elev. _____ Location NW NW SE

FIRST REPORT

330 Ft. From N Line SE
330 Ft. From W Line Quarter

1st. Report JUL 8 1953

Completion _____

Remarks _____

G-M-R - Contr.

Spudding Date 7-5-53

Drlg. Data _____

8" @ 236 Drlg. 1785

J. G. McGEHEE

J. G. McGEHEE