

Sec. 21 Twp. 14 R. 21 W

Well No. # 4 Zeeman Farm _____

Deep Rock Company _____

G-M-R Contractor _____

Sunny Slope Pool


990 Ft. from N. Line

_____ Ft. from S. Line

_____ Ft. from E. Line

990 Ft. from W. Line

SE NW SE

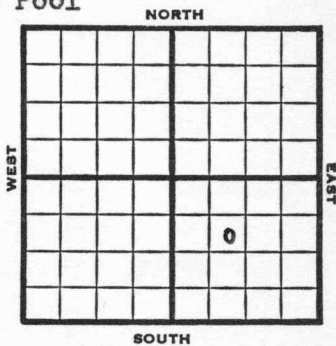

1953

Elev. 2176'

REPORT

6/17

Location

6/24

8" @ 248

7/1

Anhy 1508, Heeb 3463, Tor 3484,
Lans 3502

Drlg. 3673'

7/8

B KC 3750, Arb 3960.

RTD 3772'

5" @ 3971'

7/22

NR

8/12

Spud 6-23-53 Oil well TD 3972
8" @ 248 Anhy 1508 Heeb 3463
Tor. 3484 Lans 3502 B KC 3750
Arb. 3960 TD 3972 5" @ 3971
CO to 3939 16/3905-09 B/1/2 GWPH
500 A S/1/2 BAW 3 hr. S/1/2 BOPH
S/4-3/4 BO SP 3888 St-frac.
Comp. 100 BOPD

COMPLETED

