


Section 22 Township 14 Range 21W

Well No. #1 Colberg

Company Superior Oil

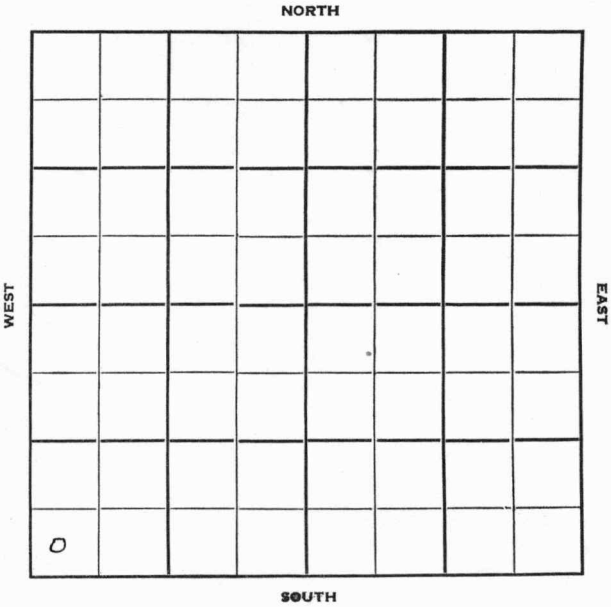



Sec. 22 Twp. 14 R. 21 W

Well No. # 1 Colberg Farm

Superior Oil Company

Contractor


Ft. from N. Line

330 Ft. from S. Line

Ft. from E. Line

330 Ft. from W. Line

SW SW SW

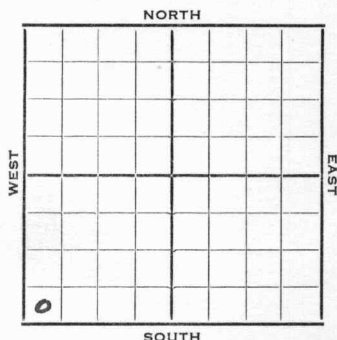

1952

REPORT

4/30

Location

5/7

"

5/14

"

5/21

"

5/28

"

6/11 10" @ 245'

6/18 Anhy 1420 Topeka 3160 Drlg. 3370'

6/25 Heeb 3384' Dodge 3402' Lans. 3420'
DST 3424-60, 1 hr, 35' HO & GCM
DST 3490-3530, 1 hr, 155' GCM & SO
1080# Marm 3762'
DST 3762-86, 1 hr, 93' O & GCM 950#
Drlg. 3800'

7/2 Sd 3820 RTD 3875 7" @ 3875
18/3821-24 30/3830-35 5 Boph

7/9 S/10 BOPH Hyd No help POP

7/17 NR

7/23 P/ 120 Bopd

7/30 NR

8/6 "

8/13 Spud 6-8-52

Oil Well TD 3875 10" @ 245'

Anhy 1420 Top. 3160

Heeb. 3384 Dodge 3402

Lans. 3420

OVER

1952

8/13 DST 3424-60 open 1 hr. rec. 35' HO&GCM
O#
DST 3490-3530 open 1 hr. rec. 155'
gcm & so 1080# Marm. 3762
DST 3762-86 open 1 hr. rec. 93' O&GCM
950# Sand 3820 TD 3875
7" @ 3875 18/ 3821-24 30/ 3830-35
5 boph S/ 10 boph Hydro.
P/ 120 bopd
Comp. 116 bopd


COMPLETED

County Trego State Kansas
 Sec. 22 (Blk.) 14 (Sur.) 21W Map No.
 (Twp.) (Rge.)

Operator Superior Oil

Well No. 1 Farm Colberg

Elev. 2095 Location SW SW SW

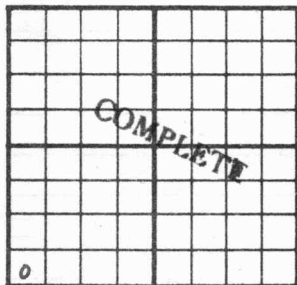

330 Ft. From S Line SW

330 Ft. From W Line Quarter

1st. Report

Completion AUG 13 1952

Remarks

Spudding Date 6-8-52

Drlg. Data Oil well TD 3875

10" @ 245 Anhy 1420 Top. 3160

Heeb. 3384 Dodge 3402 Lans. 3420

DST 3424-60 open 1 hr. Rec. 35' ho & gcm

0# DST 3490-3530 open 1 hr. Rec. 155'

gcm & so 1080# Marm. 3762 DST 3762-

86 open 1 hr. Rec. 93' o & gcm 950#

Sand 3820 TD 3875 7" @ 3875

18/ 3821-24 30/ 3830-35 5 boph

S/ 10 boph Hydro. P/ 120 bopd

Comp. 116 bopd

J. G. McGEHEE

County **Trego** State **Kansas**

Sec. **22** (Blk. **14** (Sur. **21W** Map No.

Operator Superior Oil

Well No. **1** Farm **Colberg**

Elev.	Location	SW	SE	SV
-------	----------	----	----	----

330 Ft. From **S** Line **SW**

330	Ft. From	W	Line	Quarter
-----	----------	---	------	---------

1st. Report **APR 30 1952**

Completion

Remarks

Spudding Date _____

Drlg. Data

Location

J. G. McGEHEE