


Section 22 Township 14 Range 21 W

Well No. # 1 Augustine Colburg (Coleberg)

Company C & G Drlg.

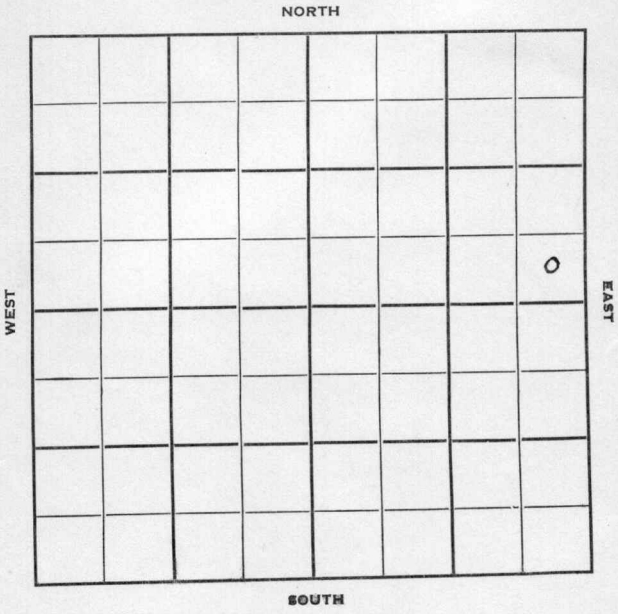

Trego

KANSAS

Sec. 22 Twp. 14 R. 21W

Well No. #1 Colberg ~~Augustine~~ Farm

C & G Drlg. Company

Contractor

**Wildcat**


Ft. from N. Line

330 Ft. from S. Line

330 Ft. from E. Line

Ft. from W. Line

SE SE NE  
Superior & CSO - DHM

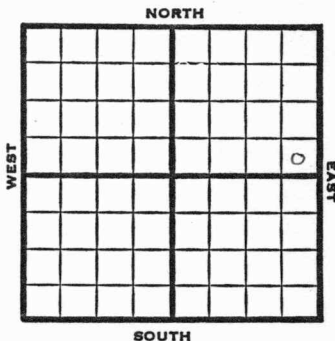

1951 Elev. 2217' REPORT

10/3  
10/31

**Location**  
 Spud -  
 D&A TD 4060  
 8" @ 222  
 Anhy 1587 Top. 3332  
 Heeb. 3551 Tor. 3576  
 Lans. 3593 B K C 3842  
 Marm. 3934 Cong. 3998  
 Arb. 4027  
 TD 4060  
 D&A

**ABANDONED**



Kansas

Map No. \_\_\_\_\_ Sec. 22 Twp. 14 R. 21W

Well No. 1 Colberg

C & G Drlg. Company

**CORRECTION**

\_\_\_\_\_  
Contractor

SE SE NE

**SECTION PLAT**

			o

\_\_\_\_\_ Ft. from N. Line

330 Ft. from S. Line

330 Ft. from E. Line

\_\_\_\_\_ Ft. from W. Line

Trego County

Location \_\_\_\_\_

Rig up \_\_\_\_\_

Drilling and Remarks:

Reported

#1 Augustine

**RECORD**

Cased \_\_\_\_\_ in., \_\_\_\_\_ ft.

Sand \_\_\_\_\_

Gas \_\_\_\_\_

Oil \_\_\_\_\_

Total Depth \_\_\_\_\_

**PRODUCTION**

1st 24 hrs. Nat. \_\_\_\_\_

1st 24 hrs. after shot \_\_\_\_\_

Gas \_\_\_\_\_ Cu. Ft.

Dry Hole \_\_\_\_\_

Abandoned \_\_\_\_\_

Date

OCT 24 1951

J. E. TYRA

Scout

