


KANSAS
Range 13W

Section 20 Township 14

Well No. #3 Rogg "C"

Company Shields Oil Prod.

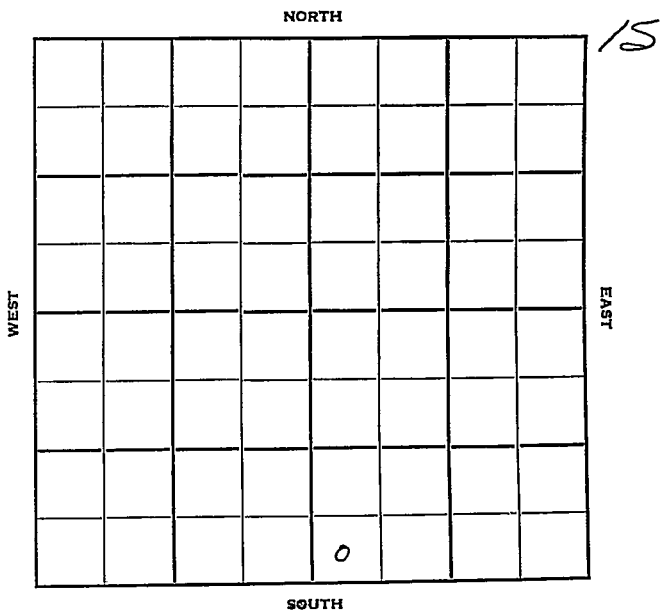

Russell

KANSAS

Sec. 20 Twp. 14 R. 13 W ✓

Well No. # 3 Rogg "C" Farm

Shields Oil Prod. Company

Contractor

Hall-Gurney Pool


Ft. from N. Line

330 Ft. from S. Line

Ft. from E. Line

330 Ft. from W. Line

SW SW SE

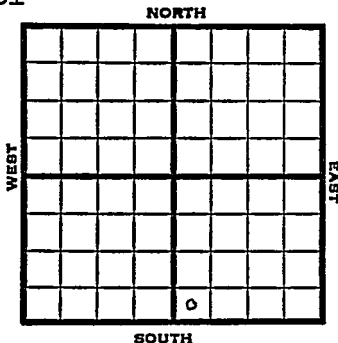

1951

Elev. 1774' REPORT

8/29
10/17

Location

Spud 9-5-51

Oil Well TD 2362

12" @ 410

Anhy 725

10" @ 733

SSO 2026-34

8" @ 2074 B/1 bopd

Tarkio 2221

7" @ 2226

Sand 2293 TD 2362

5" @ 2362

48/2316-22 B/15 boph

Hydrofrac S/4 boph 5% wtr

21/2221-24 S/1/2 boph 2000 A

Comp. 90 bopd

COMPLETED

