



Sec. 20 Twp.

O.W.D.D.

13W

Well No. #4 Rogg (C) Farm

Shields Oil Prod. Company

Shields Contractor


Ft. from N. Line

330 Ft. from S. Line

Ft. from E. Line

990 Ft. from W. Line

SE SW SE

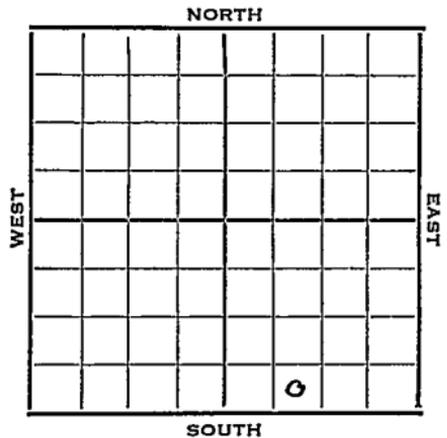

1952 Elev. 1772' REPORT

5/7 Cable tools  
 5/14 15" @ 56' 12" @ 435 Anhy 725'  
 Drlg. 805'  
 5/21 10" @ 733 Drlg. 1750  
 5/28 Indian Cave sd 1993-2002' HF oil  
 F wild for 3 hrs. TD 2013' PB 1993'  
 8" @ 1993' WOC  
 6/4 Spud 5-7-52  
 Oil Well TD 2013  
 15" @ 56 12" @ 435  
 Anhy. 725' 10" @ 733  
 Indian Cave 1993-2002  
 HFO F/wild for 3 hr. TD 2013  
 PB 1993 8" @ 1993 DP to 2013  
 S/7 boph Comp. 25 bopd

**COMPLETED**

1953 O.W.D.D

6/10 Indian Cave Sd 1993-2013 OTD DD  
 7" @ 2098'  
 SO 2160-65 1st Tarkio 2295  
 30 go 1 hr. 2nd Tarkio sd 2308-25  
 5" @ 2321'

**OVER**









1953

#4 Rogg "C"

6/17 Oil Well  
TD 2321'  
Indian Cave Sd 1993-2002  
7" @ 2098'  
SO 2160-65 1st Tarkio 2295, 30 go  
1 hr. 2nd Tarkio 2308-25  
5" @ 2321  
TD 2321'  
CO to TD  
24/ 2279-81 36/ 2285-88  
Hydro S/ 5 boph 18 hr.  
Comp. 25 bopd.

**COMPLETED**