


Section 31 Township 13 Range 19W

Well No. #10 Reidel

Company Texas Co.

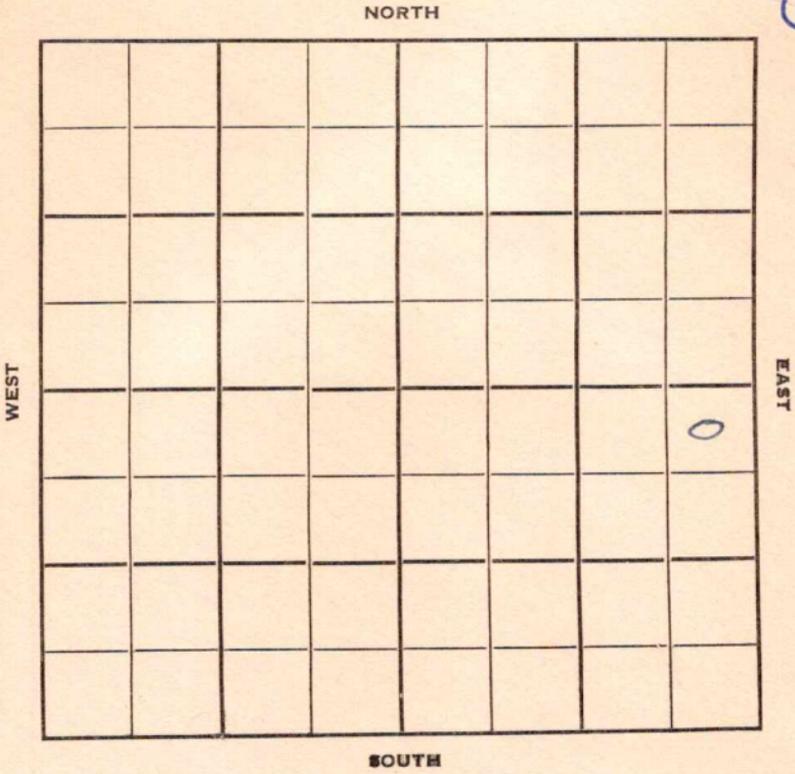

Ellis

Sec. 31 Twp. 13 R. 9W **KANSAS**

Well No. #10 Reidel Farm _____

 Texas Company _____ Company
 _____ Contractor


330 Ft. from N. Line

_____ Ft. from S. Line

330 Ft. from E. Line

_____ Ft. from W. Line

SE $\frac{1}{4}$ NE NE SE

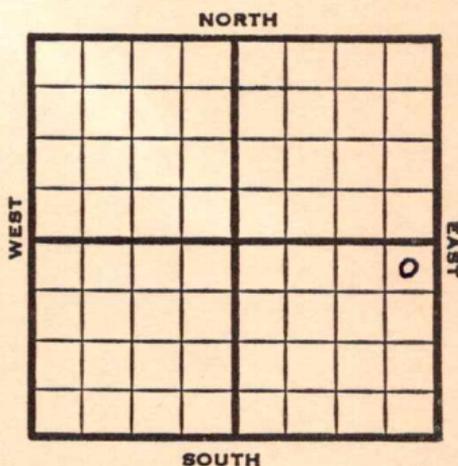

1952 **Elev. 2248'** REPORT

11/5 Spud 10-31-52
 10" @ 227'
 Drlg. 2125'

11/12 **Topeka 3236 Heeb. 3496**
Lans. 3540
 Drlg. 3759'

11/20 **Cong. 3839' Arb. 3867'** TD 3885'
 7" @ 3868'

11/27 CO 3885, S/78 BO 11 hr., 500A

12/4 NR

12/11 S/88 BO 5Hrs. S/16 $\frac{1}{2}$ BO 4 Hrs. POP

12/17 Spud 10-31-52

Oil Well

TD 3885'

10" @ 227

Top 3236, Heeb. 3496, Lans. 3540.

Cong 3839', Arb. 3867'

TD 3885

7" @ 3868

CO to 3885

S/78 bo 11 hr., 500A

S/88 bw 5 hrs., S/16 $\frac{1}{2}$ bopd

Comp. 427 bopd

COMPLETED

