

KANSAS


FORM 51 5M 4-41 PETROL

Russell

Section 20 Township 14 Range 13-W

Well No. 2 Rogg "B"

Company Cities Service Oil

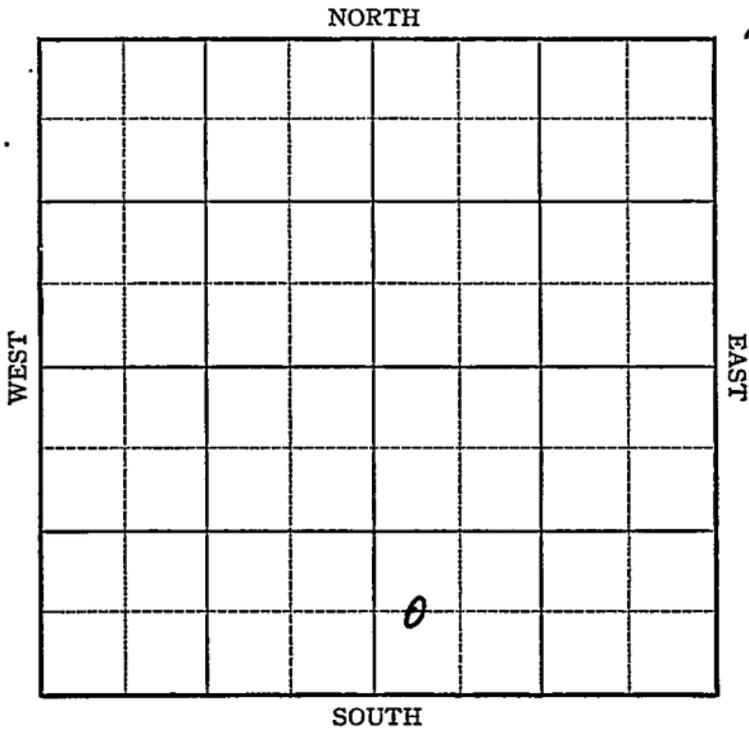

Sec. 20 Twp. 14 R. 13-W

Well No. #2 Rogg "B" Farm


Cities Service Oil Company
(Hall Gurney)

 Ft. from N. Line

660 Ft. from S. Line

 Ft. from E. Line

330 Ft. from W. Line

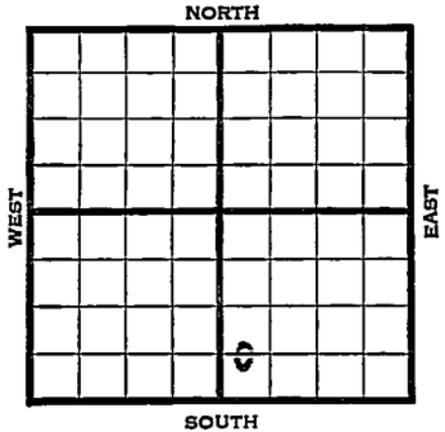

1941	REPORT
7/9	8" - 348' WOC.
7/17	Lans. 2923' Drlg. 3098'
7/23	Gorham 3231'
	T.D. 3242'
	Water.
	ABANDONED

Map No. _____ Sec. 20 Twp. 14 R. 13W

Well No. 2 Rogg "B"

Cities Service Oil _____ Company

Contractor _____

FIRST REPORT

SECTION PLAT

C W L SW SE

_____ Ft. from N. Line

660 Ft. from S. Line

_____ Ft. from E. Line

330 Ft. from W. Line

		o	

HALL GURNEY POOL

Location _____

Rig up _____

Drilling and Remarks:

8" - 348 WOC

RECORD

Cased _____ in., _____ ft.

Sand _____

Gas _____

Oil _____

Total Depth _____

PRODUCTION

1st 24 hrs. Nat. _____

1st 24 hrs. after shot _____

Gas _____ Cu. Ft.

Dry Hole _____

Abandoned _____

Date

JUL 9 1941 19

S. J. LEWIS Scout

Map No. _____ Sec. 20 Twp. 14 R. 13WWell No. 2 Rogg "B"

_____ Cities Service Oil _____ Company

_____ ABANDONED _____ Contractor

C W L SW SE

_____ Ft. from N. Line

660 Ft. from S. Line

_____ Ft. from E. Line

330 Ft. from W. Line

HALL GURNEY POOL

SECTION PLAT

		o	

Location _____

Rig up _____

Drilling and Remarks:

*Go down 323'**Water.*

RECORD

Cased _____ in., _____ ft.

Sand _____

Gas _____

Oil _____

Total Depth 3242

PRODUCTION

1st 24 hrs. Nat. _____

1st 24 hrs. after shot _____

Gas _____ Cu. Ft.

Dry Hole _____

Abandoned _____

Date

JUL 23 1941 19S. J. LEWIS Scout