


Section 21 Township 14 Range 21 W

Well No. # 2 Zeman

Company Deep Rock

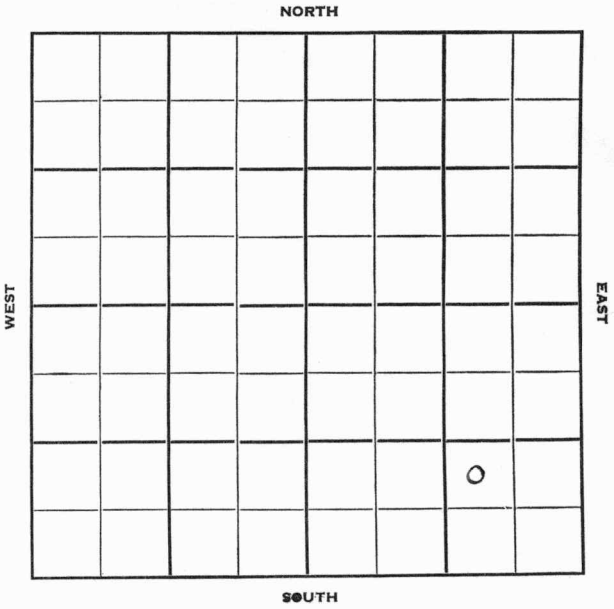

Trego

KANSAS

Sec. 21 Twp. 14 R. 21W

Well No. #2 Zeman Farm

Deep Rock Company

Creekmore Drlg. - Contr. Contractor

Sunny Slope Pool


Ft. from N. Line

990' Ft. from S. Line

990' Ft. from E. Line

Ft. from W. Line

NW SE SE

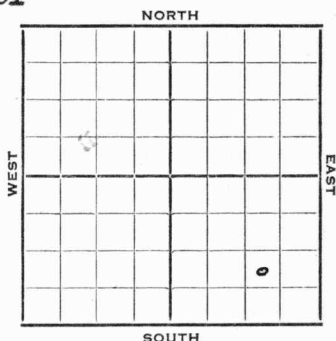

1952 Elev. 2171' REPORT

- 2/20 MIT
- 3/5 Lans 3498'
DST 3663-3700', 1 hr, 60' HOCM
BHP 90#
Drlg. 3780'
- 3/11 Miss 3837 DST 3845-54, 1/2 hr. 32' m
KH Shale 3888 KH sd 3901
F 3901-17, 11 1/2 sd stone & shale &
limestone DST 3901-17, 1 hr. 2772' oil
1108# F 3917-26 9' shale NS F 3926-33
7' sdy li stone Arb. 3988 RTD 4004
Sch. 7" @ 4000
- 3/19 CO to 3957 30/3904-09 fill up 1000'
oil 1 hr. S/55 BO 2 1/2 hr. fill up
2900' oil 5 hr . S/28 BOPH POP

OVER

1952

4/2 Spud 2-21-52
Oil Well TD 4004
10" @ 258 Lans. 3498
DST 3663-3700 opn 1 hr
Rec. 60' hocm Miss 3837
DST 3845-54 opn $\frac{1}{2}$ hr. Rec. 32' mud
KH shale 3888 Kh sand 3901
DST 3901-17 opn 1 hr. Rec
2772' oil Arb. 3988
TD 4004 7" @ 4000
CO to 3957 30/3904-09
FU 1000' oil 1 hr
S/55 bo $2\frac{1}{2}$ hr. FU 2900' oil 5 hr.
S/28 boph Comp. 571 bopd

COMPLETED

