



Russell

KANSAS ✓

Sec. 20 Twp. 14 R. 13W

Well No. #5 Rogg "C" Farm \_\_\_\_\_

Shields Oil Company \_\_\_\_\_

Hall-Gurney Pool Contractor \_\_\_\_\_


\_\_\_\_\_ Ft. from N. Line

330 Ft. from S. Line

990 Ft. from E. Line

\_\_\_\_\_ Ft. from W. Line

SW SE SE

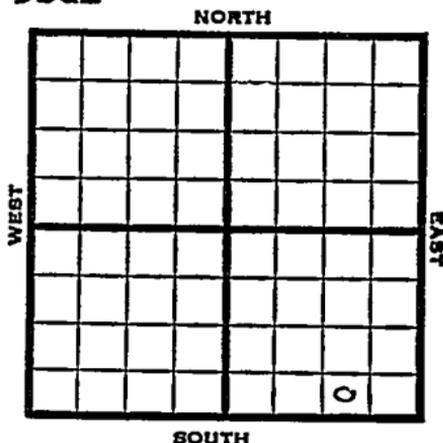

1952

Elev. 1769' REPORT

10/8	Location
10/15	"
10/22	C&P
10/29	"
11/5	"
11/12	"
11/20	"
11/27	Dr lg. 730'
12/4	Ø1200
12/11	Ø2085
12/18	7" @ 2446 TD 2446
12/25	" " "
12/30	Spud 11-19-52 Oil Well TD 2470 15" @ 34 12" @ 407 10" @ 727 Anhy 735, SSO 1834-45, Tarkio 2346, 7" @ 2470 TD 2470 42/2308-15, sd-frac 1 boph PB 2304 36/2298-2304 sd-frac 1/2 boph 12 hrs. CO to 2330, Hydro S/4 bopd 8 hrs. Comp. 50 bopd <b>COMPLETED</b>



