


Trego

Section 26 Township 14 Range 21W

Well No. 1 Colborg 'B'

Company Jones, Shelburne & Farmer

NORTH

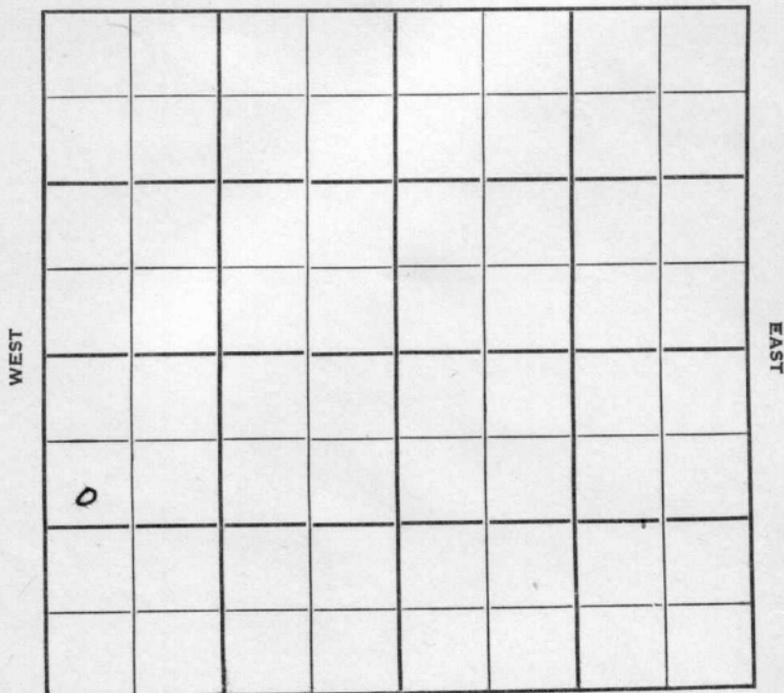

SOUTH

Sec. 26 Twp. 14 R. 21 W

Well No. # 1 Colborg "B" Farm

Jones, Shelburne & Farmer Company

Contractor

Groff Pool


990 Ft. from N. Line

_____ Ft. from S. Line

_____ Ft. from E. Line

330 Ft. from W. Line

SW NW SW

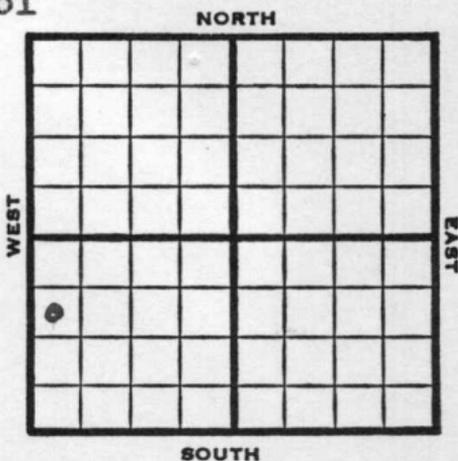

1952	Elev. 2103'	REPORT
12/17	Location	
12/25	Location	
1/1	Heeb 3404 Tor 3425 Lans 3444 DST 3514-34	
1/8	DST 3514-34 1 Hr. 400' SW 1030# DST 3781 3500 1/2 Hr. 10' M 940# Cong 3838 DST 3839-51 1 Hr. 200' SW 780# DST 3854-66 1 Hr. 168' oil 820# Arb 3881 TD 3886 5" @ 3885	
1/22	CO 3886'	15/3857-62 5 BFPH Est 10% wtr.
1/28	Spud 12-18-52 Oil Well TD 3886 8" @ 165 Anhy 1425, Heeb 3404, Tor 3425, Lans 3444 DST 3514-34, opn 1 hr., rec. 400 sw 1030# DST 3781-3800, opn 1/2 hrs., rec. 10' mud, 940# Cong 3838 DST 3839-51, opn 1 hr., rec. 200' sw 780# DST 3854-66, opn 1 hr., rec. 168' oil 820# Arb. 3881	

3838
783
1735

OVER

#1 Colborg "B"

(Information Brought Forward)

1953

1/28

TD 3886

5" @ 3885

CO to 3886

15/3857-62, 5 bfph 10% wtr.

P/ 2 boph 27% wtr.

Comp. 25 bopd 27% wtr.

COMPLETED

REPORT

