


Section 26 Township 14 Range 21W

Well No. 2 Groff

Company Jones, Shelburne & Farmer

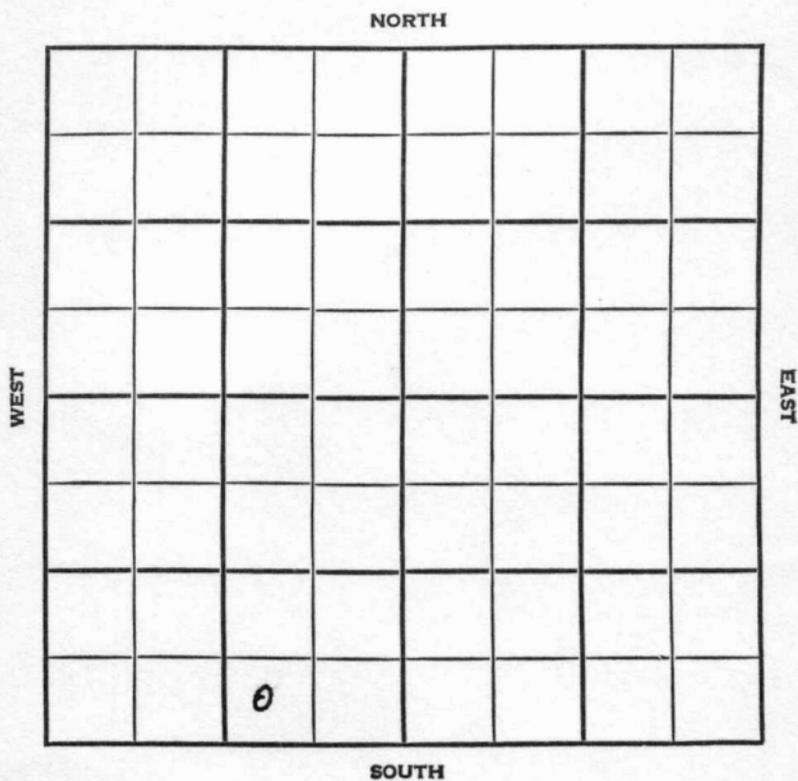

Trego


KANSAS

SEC.	26	TWP.	14	R.	21W	✓
------	----	------	----	----	-----	---

WELL NO. #2 Groff FARM

COMPANY Jones, Shelburne & Farmer

CONTRACTOR J-S-F

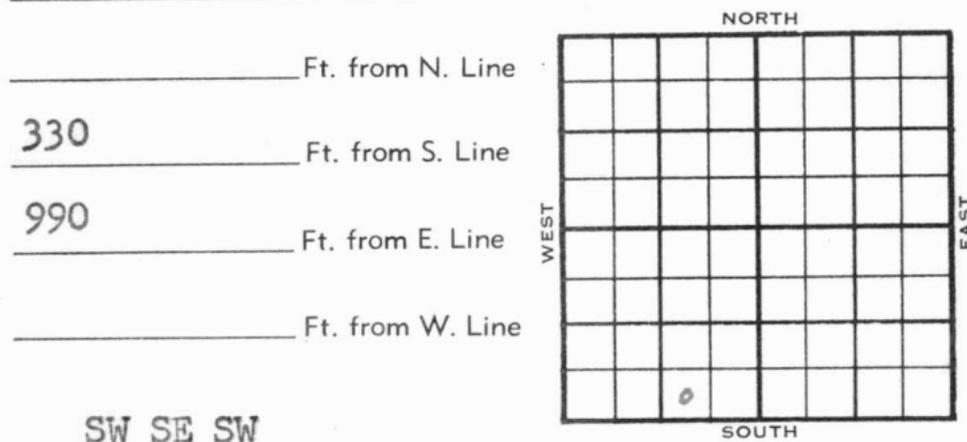

1954

ELEVATION  
2095

REPORT

5/26

M I R

6/2

NR

6/23

8" @ 160'  
 KC 3429'  
 Drlg. 3475'

6/30

Spudding 6-14-54  
 D & A  
 TD 3880  
 8" @ 160  
 KC 3429  
 DST 3505-25 open 1/2 hr. Rec. 420'  
 sm & ocv 1180#  
 BKC 3681 Marm 3768 Cong. 3832  
 DST 3813-56 open 1/2 hr. Rec. 2' ocm  
 18' mud 82#  
 Arb. 3866  
 TD 3880  
 D&A

**ABANDONED**



