


Section 32 Township 13 Range 19 W

Well No. # 3 Cave

Company United Drlg.

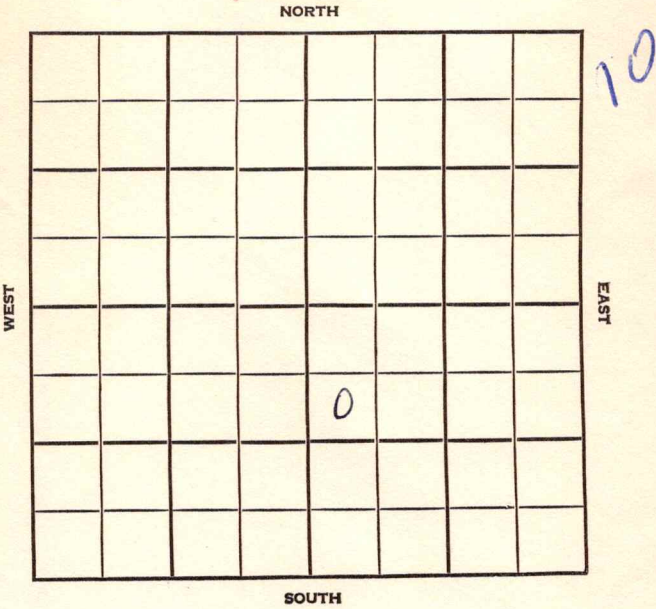

Ellis

KANSAS

SEC.	TWP.	R.
32	13	19 W

WELL NO.

3 Cave

FARM

COMPANY

United Drlg.

CONTRACTOR

Irvin Pool


990 Ft. from N. Line

Ft. from S. Line

Ft. from E. Line

330 Ft. from W. Line

SW NW SE

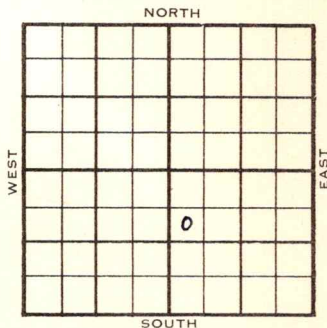

1954

ELEVATION

2259'

REPORT

8/11

Spud 8-4-54

Drlg. 3295'

9/29

Spud 8-4-54

Oil Well

TD 3908'

Heeb 3515', Tor 3534', Mans 3561'

B KC 3805', Marm 3850', Cong 3861'

Arb 3901'

DST 3903'-08' opn 1 hr, rec 350' gas,
270' clean oil, 80' frog oil 905#

TD 3908'

5" @ 3903'

CO to 3908'

FU 200' oil 2 hr. S/ 4½ boph FU 1800'
oil 12 hr.

Comp 50 bopd.

COMPLETED

County **Ellis** State **Kansas**
 Sec. **32** (Blk.) **13** (Sur.) **19W** Map No.

Operator **United Drlg.**

Well No. **3** Farm **Cave**

Elev. Location **SW NW SE**

FIRST REPORT

990 Ft. From **N** Line **SE**

330 Ft. From **W** Line Quarter

1st. Report **AUG 11 1954**

Completion

Remarks

Spudding Date **8-4-54**

Drlg. Data

Irvin Pool

drlg. 3295

County Ellis State Kansas
 Sec. 32 (Blk. 13) (Sur. Rge.) 19W Map No. _____
 Operator United Drlg.
 Well No. 3 Farm Cave
 Elev. 2259 Location SW NW SE



990 Ft. From N Line SE
330 Ft. From W Line Quarter

1st. Report Aug 11 1954

Completion SEP 29 1954

Remarks _____

Spudding Date 8-4-54

Drlg. Data Oil well TD 3908 Irvin Pool
 Heeb. 3515 Tor. 3534 Lans. 3561
 B KC 3805 Marm. 3850 Cong. 3861
 Arb. 3901 DST 3903-08 open 1 hr. Rec.
 350' gas 270' clean oil 80' frog oil
 905# TD 3908 5" @ 3903 CO to 3908
 FU 200' oil 2 hr. S/ 4 $\frac{1}{2}$ boph FU 1800'
 oil 12 hr. Comp. 50 bopd

FABEN GILSTRAP