


SECTION 31 TOWNSHIP 13 RANGE 19W

WELL NO. #2 Riedel "B"

COMPANY W.S. Brunson

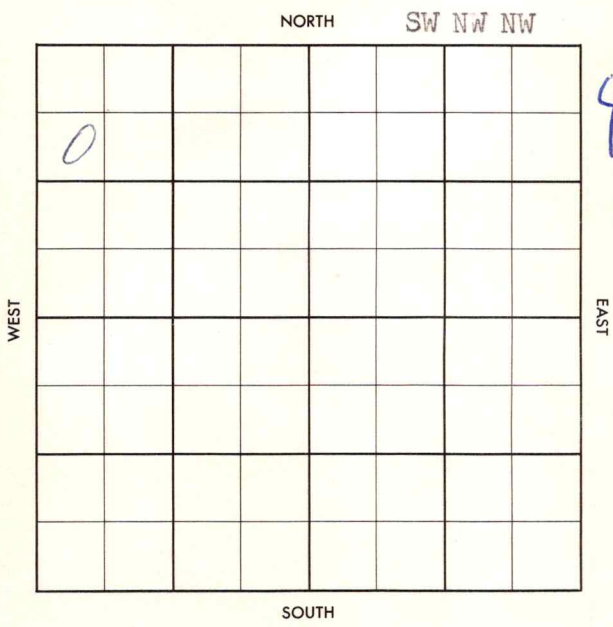

Ellis

KANSAS


SEC.	TWP.	R.
31	13 S	19 W

WELL NO. # 2 Riedel "B" FARM

COMPANY W. S. Brunson

CONTRACTOR Barnett Drlg.
Irvin

_____ FT. FROM N. LINE
 _____ FT. FROM S. LINE
 _____ FT. FROM E. LINE
 _____ FT. FROM W. LINE

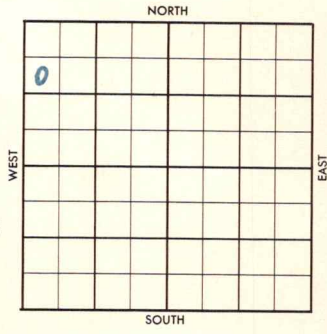

SW NW NW

SDX-1/2 Mile

1957	ELEVATION	REPORT
------	-----------	--------

6/12

Comm. 6-6-57
 8" @ 206/125
 Drlg. 3185'
 Anhy 1500'

(FR Tkt)

4285

County Ellis Elev. _____
 Sec. 31 Twp. 13 Rgs. 19W
 Company W. S. Brunson
 Farm Name Riedel "B" No. 2

TOPS	DEPTH	LOG	DATUM	Loc. in Sec.
Anh.	1500			SW NW NW
Tp.				
H.				
Tr.				
Dg.				
B.L.				
L.				
K.C.				Geol. _____
B.K.C.				Contr. _____
Ce.				Barnett Drlg.
C.				
M.				Pool
M.				Irvin
K.				
Mz.				
Ma.				
V.				
S.				
S.				
A				FIRST REPORT
R.				
PE.				
G.				1 JUN 12 1957
				1/2 mile
T.D.				

Date Comm. 6-6-57
8" @ 206/125, Drlg. 3185

~~14~~

1285 T. & H. C. M. M.

Co.
Lse.
No.
Sec.
T.
R.

County Ellis Elev. 2215
 Sec. 31 Twp. 13 Rge. 19W
 Company W. J. Brunson
 Name Hiedel "B" No. 2

	DEPTH	LOG	DATUM	Loc. in Sec.
Surf	150			SW NW NW
Tr.	3456			
Dg.	3475			
Bl.				
L.	3497			Geol.
K.C.				Contr.
B.K.C.				Barnett Drlg.
Ce. <u>Marm</u>	3775			Pool
C.	3798			Irvin
M.				
M.				
K.				
Mz.				
Mq.				
V.				
S.				
S.				
A.	3851			COMPLETE
R.				$\frac{1}{2}$ mile
PE.				AUG 7 '57
G.				
T.D.	3856			

Date Comm. 6-6-57
 8" @ 206/125, Drlg. 3185 JUN 19 57 @ 3820
 JAN 28 57 DST 3849-56 1hr rec
 3020' oil BHP 1098 5 1/2 o.
 3851 / co DD 3858 TD 8
 70 Boph no lw 2000' o.B
 POP JUL 3 57 X Wo Pump JUL 10 57 X
 POP JUL 17 57 X JUL 24 57 X JUL 31 57 X no pump test
 Fig 57 57 AUG 18 57 Draw down
 3000 Boph no lw.