


Section 32 Township 13 Range 19W

Well No. 2 Cave

Company Murfin Drlg.

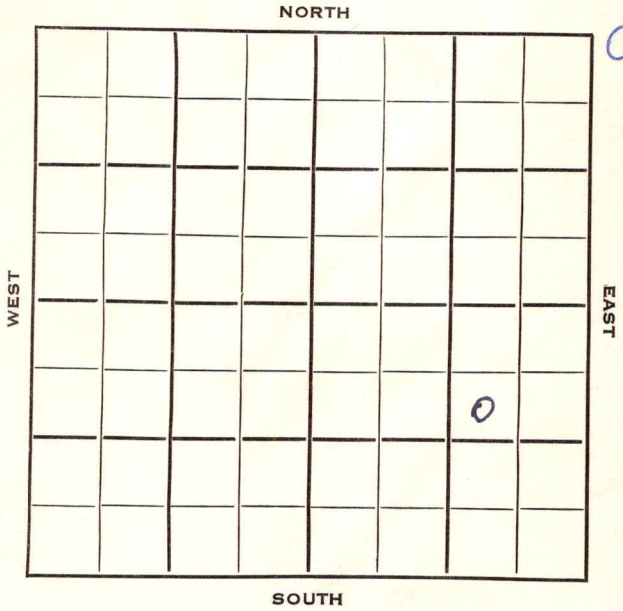


SEC. 32	TWP. 13	R. 19W
------------	------------	-----------

WELL NO. #2 Cave FARM

COMPANY Murfin Drlg.

CONTRACTOR Murfin Drlg.

990 Ft. from N. Line
 _____ Ft. from S. Line
 990 Ft. from E. Line
 _____ Ft. from W. Line

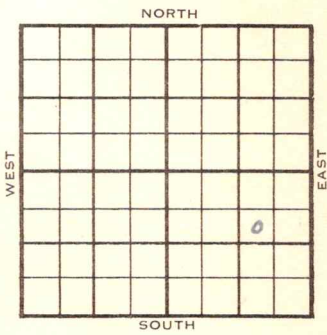

SW NE SE

1953	ELEVATION 2260'	REPORT
------	--------------------	--------

10/28 M I M
 11/4 8" @ 182 Anhy 1565
 Drlg. 2930'
 11/11 Top 3276' Heeb 3524' Lans 3568'
 Drlg. 3580'
 11/18 Spud 10-27-53
 D & A
 TD 3937'
 8" @ 182'
 Anhy 1565', Top 3276', Heeb 3524',
 Lans 3568'. Arb 3926'
 TD 3937'
 D & A

ABANDONED

